

MONROE  
 651  
 10/19/74

MISSISSIPPI  
 BOARD OF WATER COMMISSIONERS  
 416 North State Street  
 Jackson, Mississippi 39201

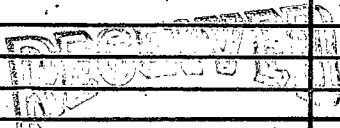
WATER WELL DRILLERS LOG CODED

10/19 74  
 date well completed

Herman Homan Well & Supply, Inc.  
 P. O. Box 42

MONROE  
 county well located

SHANNON, MISSISSIPPI 38668

LANDOWNER:	description of formations encountered	from	to
Johnnie Lee Baker Rt 1, Aberdeen, Miss (mailing address)	Surface sand & clay Blue clay sand bottom	0 25 90 200	75 90 200
WELL LOCATION: sec. 30 T. 13 N R. 7 E S W 3 miles S of Wood (distance) (direction) (nearest town)			
WELL PURPOSE: Home (home, irrigation, municipal, industrial)			
WELL COMPLETION DATA: (1) diameter (inches) 4 4 (2) total depth (feet) 200 (3) static water level (feet) 65 below above top of ground (4) casing (material) Feep (depth) 84' 4 4 (size) if telescope see back. (5) screen 20 (length) (depth to top) (size) (material) (6) pump 1 (HP) 5 (yield gpm) electric (type power) (7) electric log no (yes or no) (organization running log) (8) how well bottom plugged open	<div style="text-align: center; font-size: 2em; opacity: 0.5;">CODED</div>		
DRILLERS REMARKS:	<div style="text-align: center;">             NOV 18 1974            MISS. Bd. OF WATER COMMISSIONERS         </div>		

If well telescopes please sketch and show depths.

GROUND LEVEL

			X

SECTION 30

Please indicate well location X.

ADDITIONAL INFORMATION

If more than one screen, show locations of each on sketch.