

MONROE

G

WATER WELL DRILLERS LOG

4-4-61

HERNDON WELL & SUPPLY CO.

G 304

Date: April 4, 1961, Driller:

P. O. BOX 42

County

Monroe

403-S 408-6 410-5

SHANNON, MISSISSIPPI

(1) Owner of Land: Sub Sullivan  
 (Name)  
 Contractor Nettleson, Miss  
 (Address)  
 (2) Location: 1/4, 1/4, Sec. T<sup>13S</sup> R<sup>7E</sup>  
3 miles S.E., of Warr.  
 (distance) (direction) (Nearest Town)  
 (3) Topography: FLAT  
 (Hilly) (Flat) (Level)  
 (4) Purpose of Well: Home  
 (Domestic Irrigation  
 Municipal, Industrial, Other)


Description & Color of Materials Sand, Clay, Red Clay, Shell, etc.	Thick- ness Feet	Depth Feet
<u>Surface sand &amp; clay</u>		<u>0</u>
<u>Blue rock</u>		<u>20</u>
<u>Sand</u>		<u>40</u>
<u>Bottom</u>		<u>180</u>

Information upon completion of well:

(1) Diameter 4 inches.  
 (2) Total Depth 180 feet.  
 (3) Water Level 50 feet below top of ground.  
 (4) Cased to 23' 2", Size 4"  
 (5) Screen: Size —, Length —  
 (6) Were any formations sealed against pollution?  
✓ yes, — no.

If YES depth of formation 20  
 Why Surface & Sand

Drillers' Remarks:

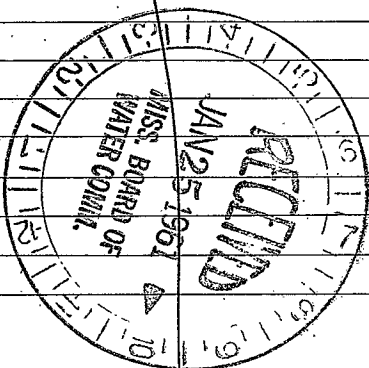

(Use Back Side)

Well No.

100

100

