

MONROE
G 2000
1-20-77

MISSISSIPPI
BOARD OF WATER COMMISSIONERS
416 North State Street
Jackson, Mississippi 39201

WATER WELL DRILLERS LOG

Herman Homan Well & Supply, Inc.

P. O. Box 42

SHANNON, MISSISSIPPI 38868

Monroe
county well located

1-20 1977
date well completed

LANDOWNER: (Contractor)
Maced Jordan
c/o Shannon MS
(mailing address)

description of formations encountered	depth	
	from	to
Surface sand	0	16
Blue clay	16	200
Sand	200	300
Bottom	300	

WELL LOCATION:
14 sec. T 23 S R. 7 E S 5 W
3 miles SE of Wren
(distance) (direction) (nearest town)

WELL PURPOSE: drinking
(home, irrigation, municipal, industrial)

- WELL COMPLETION DATA:
- (1) diameter (inches) 4 1/2
 - (2) total depth (feet) 300
 - (3) static water level (feet) 114 below above top of ground.
 - (4) casing steel 20'
(material) (depth)
4 1/2 If telescope see back.
(size)
 - (5) screen no
(length) (depth to top)
(size) (material)
 - (6) pump 1 HP 4
(HP) (yield gpm)
elec
(type power)
 - (7) electric log no
(yes or no)
 - (organization running log)
 - (8) how well bottom plugged open


RECEIVED
FEB 22 1977

DRILLERS REMARKS:

MISS. BD. OF WATER COMMISSIONERS

If well telescopes please sketch and show depths.

GROUND LEVEL

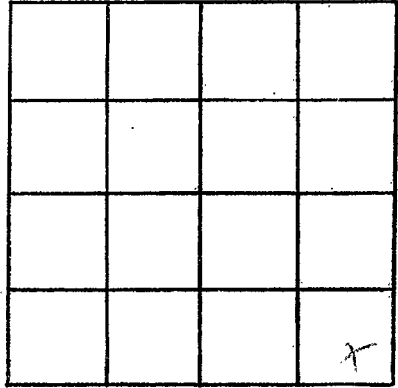

SECTION 14

Please indicate well location X.

ADDITIONAL INFORMATION

If more than one screen, show locations of each on sketch.