

Monroe
 G 2001
 3-25-77

MISSISSIPPI
 BOARD OF WATER COMMISSIONERS
 416 North State Street
 13L Jackson, Mississippi 39201

WATER WELL DRILLERS LOG

3-10 19 77 Herman Homan Well & Supply, Inc. Monroe
 date well completed firm name county well located
 SHANNON, MISSISSIPPI 38468

LANDOWNER: T. J. Halford
 description of formations encountered: surface sand
 at 3 Aberdeen, Ms (mailing address) Blue clay
 sand
 from 0 to 38
 to 38 100
 100 200
 200

WELL LOCATION:
 sec. 21 T 13 N R 7 E
 S W
 4 miles SE of Wren
 (distance) (direction) (nearest town)

WELL PURPOSE: Home
 (home, irrigation, municipal, industrial)


- WELL COMPLETION DATA:
- (1) diameter (inches) 4"
 - (2) total depth (feet) 200'
 - (3) static water level (feet) 28' below top of ground.
 - (4) casing (material) steel (depth) 4'
 4" (size) if telescope see back.
 - (5) screen (length) (depth to top) (size) (material)
 - (6) pump (HP) (yield gpm) 3
 electric (type power)
 - (7) electric log (yes or no) NO
 (organization running log)
 - (8) how well bottom plugged

DRILLERS REMARKS:

RECEIVED
 MAY 2 1977

If well telescopes please sketch and show depths.

GROUND LEVEL

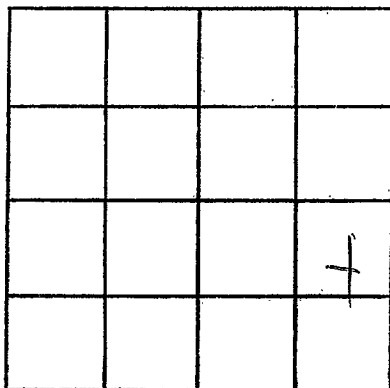

SECTION 21

Please indicate well location X.

ADDITIONAL INFORMATION

If more than one screen, show locations of each on sketch.