

Monroe
 G 204
 6-30-77

MISSISSIPPI
 BOARD OF WATER COMMISSIONERS
 416 North State Street
 134 Jackson, Mississippi 39201

WATER WELL DRILLERS LOG

6-30 date well completed 1977 firm name Mid South Drilling Co. county well located Monroe

LANDOWNER: J.B. Armstrong
Amory Miss.

| description of formations encountered | from | to |
|---------------------------------------|----------|-----------|
| <u>Sand</u> | <u>0</u> | <u>32</u> |

(mailing address)


WELL LOCATION:
 sec. 23 T. 13 N. R. 19 E.
3 miles west of Becker ms.
 (distance) (direction) (nearest town)

WELL PURPOSE:
 (home, irrigation, municipal, industrial)

WELL COMPLETION DATA:


- (1) diameter (inches) 4"
- (2) total depth (feet) 32 ft
- (3) static water level (feet) 10 below above top of ground.
- (4) casing PVC, 32 ft
(material) (depth)
- if telescope see back.
(size)
- (5) screen 10', 22 ft
(length) (depth to top)
- 4", PVC
(size) (material)
- (6) pump 1/2, 10
(HP) (yield gpm)
- 2
(type power)
- (7) electric log
(yes or no)
- (organization running log)
- (8) how well bottom plugged 1" mesh valve

DRILLERS REMARKS:

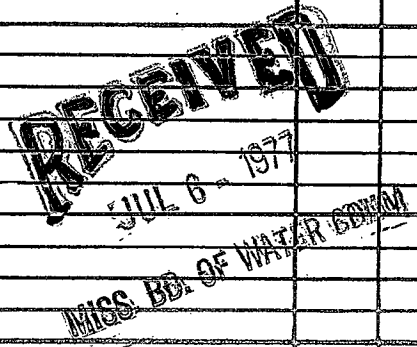

If well telescopes please sketch and show depths.

GROUND LEVEL

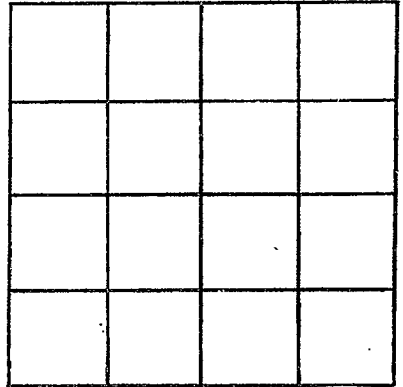

SECTION _____

Please indicate well location X.

ADDITIONAL INFORMATION

If more than one screen, show locations of each on sketch.