

**MISSISSIPPI DEPARTMENT OF ENVIRONMENTAL QUALITY**  
Bureau of Land and Water Resources

P. O. Box 10631  
Jackson, MS 39289-6311  
WATER WELL DRILLERS LOG

COUNTY WELL LOCATED <i>MONROE</i>	
WELL NUMBER <i>2006</i>	CODED
DATE WELL COMPLETED <i>7/3/91</i>	

PERMIT NUMBER
NAME OF DRILLING FIRM <i>Rossi Drilling</i>

NAME & MAILING ADDRESS OF LANDOWNER <i>Billy Parham</i> <i>P.O. Box 364</i>			
WELL LOCATION: SEC	TOWNSHIP	RANGE	
<i>22</i>	<i>135</i>	<i>N 19 E</i>	<i>W</i>
DISTANCE	DIRECTION	NEAREST TOWN	
		<i>Beekmans Bottom</i>	
OTHER LANDMARK <i>Tom Highie water way</i>			
WELL PURPOSE: <i>Home Irrigation</i> , Municipal, Industrial, Fish Pond, etc.			

<b>PUMP DATA</b>			
PUMP TYPE (Circle One): <input checked="" type="radio"/> Submersible, <input type="radio"/> Turbine, <input type="radio"/> Jet <input type="radio"/> Flowing Well, Other (Describe) _____			
POWER TYPE (Circle One): <input checked="" type="radio"/> Electric, <input type="radio"/> Tractor, <input type="radio"/> Diesel, <input type="radio"/> Gasoline, <input type="radio"/> Butane, Other (Describe) _____ H/P <i>150</i>			
Pump Capacity (GPM)	No. of Stages	Setting Depth	
<i>12</i>	<i>12</i>	<i>30'</i> FT.	
PUMP TEST			
Well yielded <i>None</i> GPM with a drawdown of _____ ft. after _____ hours of pumping			

<b>WELL DATA</b>			
Well Depth	Casing Diameter (In.)	Casing Length (Ft.)	
<i>36'</i>	<i>4"</i>	<i>26'</i>	
Type of Casing	Hole Depth	Depth to Static Water Level	
<i>PVC</i>	<i>36'</i>	<i>6'</i>	
TYPE OF COMPLETION: (Circle One or More): <input checked="" type="radio"/> Gravel Packed, <input type="radio"/> Underreamed, <input type="radio"/> Telescoped, <input type="radio"/> Natural Development, <input type="radio"/> Open Hole, <input type="radio"/> Other (Describe) _____			
Top of Lap Pipe or Reduction in Casing			
FEET		IF TELESCOPED OR MORE THAN ONE SCREEN: USE BACK PAGE	

<b>LOG DATA</b>	
TYPE OF LOG RUN (Circle One): <input type="radio"/> No Log Run, <input type="radio"/> Electric, <input type="radio"/> Gamma Ray, <input type="radio"/> Density, <input type="radio"/> Sonic, <input type="radio"/> Neutron, Other (Describe) <i>None</i>	
Name of Organization Running Log	

<b>SCREEN DATA</b>		
Diameter - Inches	Length - Feet	Slot Size - Inches
<i>4"</i>	<i>10'</i>	<i>.013</i>
Screen Type	Depth to Bottom - Feet	
<i>PVC slotted</i>	<i>Bottom to 10'</i>	

<b>GEOLOGIC DATA (Office Use Only)</b>			
Surface Elev.	Geologic Unit	Unit Thickness	Depth to Top
Subs. SWL	Date	Analysis	Aquifer Test


Driller's Remarks

DESCRIPTION OF FORMATIONS ENCOUNTERED	FROM	TO
<i>Clay</i>	<i>0</i>	<i>25'</i>
<i>Sand</i>	<i>25'</i>	<i>36'</i>

FORMATIONS CONTINUED	
FROM	TO
<b>JUN 04 1992</b>	
Dept. of Environmental Quality Bureau of Land & Water Resources	
IF MORE SPACE IS NEEDED, USE BACK	

If well telescopes please sketch and show depths.

GROUND LEVEL

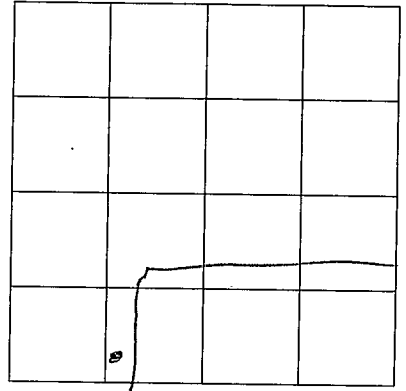

SECTION 22

Please indicate well location X.

ADDITIONAL INFORMATION

If more than one screen,  
show location of each on sketch.