

MISSISSIPPI DEPARTMENT OF ENVIRONMENTAL QUALITY
Bureau of Land and Water Resources

P. O. Box 10631
Jackson, MS 39289-0631
WATER WELL DRILLERS LOG

COUNTY WELL LOCATED <i>Madro</i>	
WELL NUMBER <i>G 2007</i>	CODED
DATE WELL COMPLETED <i>6/19/92</i>	

PERMIT NUMBER
NAME OF DRILLING FIRM <i>Rossi Drilling</i>

NAME & MAILING ADDRESS OF LANDOWNER <i>Roger Howell</i>			
<i>Rt 1 Box 231 Y</i>			
<i>Amory MS 38821</i>			
WELL LOCATION:	SEC	TOWNSHIP	RANGE
	<i>22</i>	<i>135</i>	<i>N 19 E</i>
DISTANCE	DIRECTION	NEAREST TOWN	
		<i>Beakerm</i>	
OTHER LANDMARK <i>Som higher water way</i>			
WELL PURPOSE: <input type="checkbox"/> Home Irrigation, <input type="checkbox"/> Municipal, <input type="checkbox"/> Industrial, <input type="checkbox"/> Fish Pond, etc.			

PUMP DATA		
PUMP TYPE (Circle One): Submersible, Turbine, Jet, Flowing Well, Other (Describe) _____		
POWER TYPE (Circle One): Electric, Tractor, Diesel, Gasoline, Butane, Other (Describe) _____ H/P _____		
Pump Capacity (GPM)	No. of Stages	Setting Depth FT.
PUMP TEST		
Well yielded <i>none</i> GPM with a drawdown of _____ ft. after _____ hours of pumping		

WELL DATA		
Well Depth <i>34'</i>	Casing Diameter (In.) <i>4"</i>	Casing Length (Ft.) <i>24'</i>
Type of Casing <i>Pvc</i>	Hole Depth <i>34'</i>	Depth to Static Water Level <i>5 1/2'</i>
TYPE OF COMPLETION: (Circle One or More): <input checked="" type="checkbox"/> Gravel Packed, <input type="checkbox"/> Underreamed, <input type="checkbox"/> Telescoped, <input type="checkbox"/> Natural Development, <input type="checkbox"/> Open Hole, <input type="checkbox"/> Other (Describe) _____		
Top of Lap Pipe or Reduction in Casing FEET <input type="checkbox"/> IF TELESCOPED OR MORE THAN ONE SCREEN: USE BACK PAGE		

LOG DATA	
TYPE OF LOG RUN (Circle One): No Log Run, Electric, Gamma Ray, Density, Sonic, Neutron, Other (Describe) <i>none</i>	
Name of Organization Running Log	


SCREEN DATA		
Diameter - Inches <i>4"</i>	Length - Feet <i>10</i>	Slot Size - Inches <i>.013</i>
Screen Type <i>slotted Pvc</i>	Depth to Bottom - Feet <i>Bottom to 10'</i>	

GEOLOGIC DATA (Office Use Only)			
Surface Elev.	Geologic Unit	Unit Thickness	Depth to Top
Subs. SWL	Date	Analysis	Aquifer Test
Driller's Remarks			

DESCRIPTION OF FORMATIONS ENCOUNTERED	FROM	TO	FORMATIONS (Continued)	FROM	TO
<i>clay</i>	<i>0</i>	<i>25'</i>	RECEIVED		
<i>sand</i>	<i>25'</i>	<i>34'</i>			
			<i>JUN 04 1992</i>		
			Dept. of Environmental Quality Bureau of Land & Water Resources		
			IF MORE SPACE IS NEEDED, USE BACK		

If well telescopes please sketch and show depths.

GROUND LEVEL

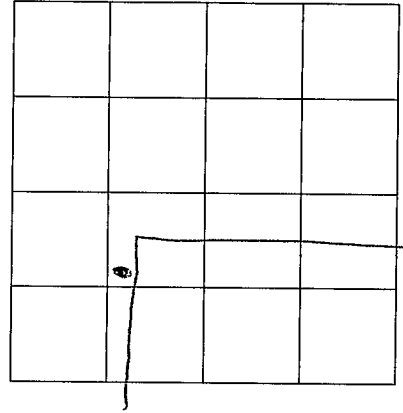

SECTION 22

Please indicate well location X.

ADDITIONAL INFORMATION

If more than one screen,
show location of each on sketch.