

MISSISSIPPI DEPARTMENT OF ENVIRONMENTAL QUALITY

Office of Land and Water Resources

P. O. Box 10631
Jackson, MS 39289-0631
WATER WELL DRILLERS LOG

COUNTY WELL LOCATED <u>Monroe</u>	
WELL NUMBER <u>GT 2012</u>	CODED
DATE WELL COMPLETED <u>10-18-97</u>	

PERMIT NUMBER
NAME OF DRILLING FIRM <u>Rossi Drilling</u>
<u>0-509</u>

NAME & MAILING ADDRESS OF LANDOWNER <u>David Colbert</u>			
<u>1510 nichols st.</u>			
<u>Aberdeen MS. 39730</u>			
WELL LOCATION:	SEC	TOWNSHIP	RANGE
	<u>25</u>	<u>13S</u>	<u>N 19</u>
DISTANCE	DIRECTION		NEAREST TOWN
<u>1/2</u> Miles	<u>west</u>		<u>Highway 25</u>
OTHER LANDMARK			
WELL PURPOSE: <u>Home</u> , Irrigation, Municipal, Industrial, Fish Pond, etc.			

PUMP DATA		
PUMP TYPE (Circle One): <input checked="" type="radio"/> Submersible Turbine Jet Flowing Well, Other (Describe) _____		
POWER TYPE (Circle One): <input checked="" type="radio"/> Electric Tractor, Diesel, Gasoline, Butane, Other (Describe) _____ H/P <u>1/2</u>		
Pump Capacity (GPM) <u>200</u>	No. of Stages <u>12</u>	Setting Depth <u>26</u> FT.
PUMP TEST		
Well yielded _____ GPM with a drawdown of _____ ft. after _____ hours of pumping		

WELL DATA		
Well Depth <u>30'</u>	Casing Diameter (in.) <u>4"</u>	Casing Length (Ft.) <u>20'</u>
Type of Casing <u>PVC</u>	Hole Depth <u>30'</u>	Depth to Static Water Level <u>18</u>
TYPE OF COMPLETION: (Circle One or More): <input checked="" type="checkbox"/> Gravel Packed, Underreamed, Telescoped, <input type="checkbox"/> Natural Development, Open Hole, Other (Describe) _____		

LOG DATA	
TYPE OF LOG RUN (Circle One): <input type="checkbox"/> No Log Run, Electric, Gamma Ray, Density, Sonic, Neutron, Other (Describe) <u>None</u>	
Name of Organization Running Log <u>None</u>	

WELL GROUTED TO A DEPTH OF _____ FEET	
Type Grout (circle one): Cement, Bentonite, or Mix	

GEOLOGIC DATA (Office Use Only)			
Surface Elev.	Geologic Unit	Unit Thickness	Depth to Top
Subs. SWL	Date	Analysis	Aquifer Test
Driller's Remarks			
Top of Lap Pipe or Reduction in Casing			
FEET		IF TELESCOPED OR MORE THAN ONE SCREEN: USE BACK PAGE	


SCREEN DATA		
Diameter - Inches <u>4"</u>	Length - Feet <u>10'</u>	Slot Size - Inches <u>1/10</u>
Screen Type <u>PVC</u>		Depth to Bottom - Feet <u>10</u>

DESCRIPTION OF FORMATIONS ENCOUNTERED	FROM	TO
<u>clay</u>	<u>0</u>	<u>19</u>
<u>sand</u>	<u>19</u>	<u>30</u>

FORMATIONS (Continued)	FROM	TO
06-02-98A09:38 RCVD		
IF MORE SPACE IS NEEDED, USE BACK		

If well telescopes please sketch and show depths.

GROUND LEVEL

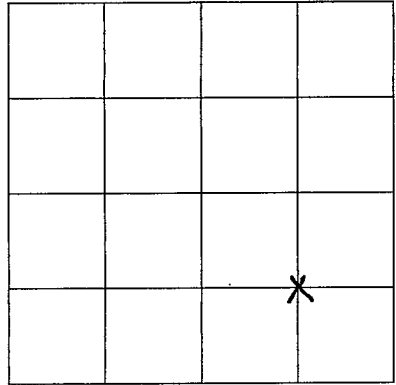

SECTION 25

Please indicate well location X.

ADDITIONAL INFORMATION

If more than one screen,
show location of each on sketch.