

MISSISSIPPI DEPARTMENT OF ENVIRONMENTAL QUALITY
Office of Land and Water Resources

P. O. Box 10631
 Jackson, MS 39289-0631
WATER WELL DRILLERS LOG

COUNTY WELL LOCATED
Montroe

WELL NUMBER CODED
G-2014

DATE WELL COMPLETED
9-27-00

PERMIT NUMBER

NAME OF DRILLING FIRM
Rossi Drilling

0-509

NAME & MAILING ADDRESS OF LANDOWNER
David Hidalgo
Po Box 392
Ormorey ms 38821

WELL LOCATION: SEC TOWNSHIP RANGE
35 14 N 19 E

DISTANCE DIRECTION NEAREST TOWN
 _____ Miles _____ of _____

OTHER LANDMARK

WELL PURPOSE: Home, Irrigation, Municipal, Industrial, Fish Pond, etc.

PUMP DATA

PUMP TYPE (Circle One):
 Submersible, Turbine, Jet, Flowing Well,
 Other (Describe) _____

POWER TYPE (Circle One):
 Electric, Tractor, Diesel, Gasoline, Butane,
 Other (Describe) _____ H/P 1/2

Pump Capacity (GPM) No. of Stages Setting Depth
 _____ FT.

PUMP TEST
 Well yielded _____ GPM with
 a drawdown of _____ ft.
 after _____ hours of pumping

WELL DATA

Well Depth <u>47</u>	Casing Diameter (in.) <u>4"</u>	Casing Length (ft.) <u>37</u>
Type of Casing <u>PVC</u>	Hole Depth <u>47</u>	Depth to Static Water Level <u>35</u>

TYPE OF COMPLETION: (Circle One or More):
 Gravel Packed, Underreamed, Telescoped,
 Natural Development, Open Hole, Other
 (Describe) _____

LOG DATA

TYPE OF LOG RUN (Circle One):
 No Log Run, Electric, Gamma Ray, Density, Sonic, Neutron,
 Other (Describe) None

Name of Organization Running Log
None

WELL GROUTED TO A DEPTH OF _____ FEET
 Type Grout (circle one): Cement, Bentonite, or Mix

GEOLOGIC DATA (Office Use Only)

Surface Elev.	Geologic Unit	Unit Thickness	Depth to Top
Subs. SWL	Date	Analysis	Aquifer Test

SCREEN DATA

Diameter - Inches <u>4"</u>	Length - Feet <u>10</u>	Slot Size - Inches <u>.010</u>
Screen Type <u>PVC</u>	Depth to Bottom - Feet <u>10'</u>	

Driller's Remarks

Top of Lap Pipe or Reduction in Casing

FEET IF TELESCOPED OR MORE THAN ONE SCREEN: USE BACK PAGE


DESCRIPTION OF FORMATIONS ENCOUNTERED	FROM	TO
<u>Clay</u>	<u>0</u>	<u>26</u>
<u>Sand and Gravel</u>	<u>26</u>	<u>47</u>

FORMATIONS (Continued)	FROM	TO

REC'D JUN 25 2001

If well telescopes please
sketch and show depths.

GROUND LEVEL

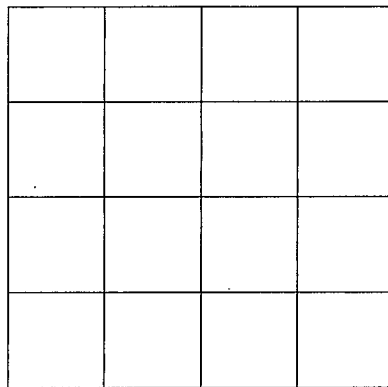

SECTION _____

Please indicate well location X.

ADDITIONAL INFORMATION

If more than one screen,
show location of each on sketch.
