

Monroe

H4

8-66

MISSISSIPPI BOARD OF WATER COMMISSIONERS

WATER WELL DRILLERS LOG

CODED

Date: 8-4, 1966, Driller: J.C. REEVES County MONROE

(When well drilled)

(Name)

(Where well is located)

(1) Owner of Land: JOHN SMITH

(Name)

ABERDEEN, MISS.

NENE (Address) 27 102nd

(2) Location: SE 1/4, SE 1/4, Sec. 22 T13R8

8 miles E of AMORY (distance) (direction) (Nearest Town)

(3) Topography: Hilly (Hilly) (Flat) (Level)

(4) Purpose of Well: DOM. (Domestic Irrigation, Municipal, Industrial, Other)

Description & Color of Materials Sand, Clay, Red Clay, Shell, etc.

Thickness Feet

Depth Feet

RED CLAY 22 0
RED SAND 91 22

CODED

Information upon completion of well:

(1) Diameter: 4 inches.

(2) Total Depth: 113 feet.

(3) Water Level: 57 feet below top of ground.

(4) Cased to: 93', Size: 4" PVC

(5) Screen: Size: 4", Length: 20'

(6) Were any formations sealed against pollution? yes, no.

If YES depth of formation


Why

Drillers Remarks:

Yield in gpm: 8

Size pump: 3/4 HP. JET

Type power: ELECTRIC

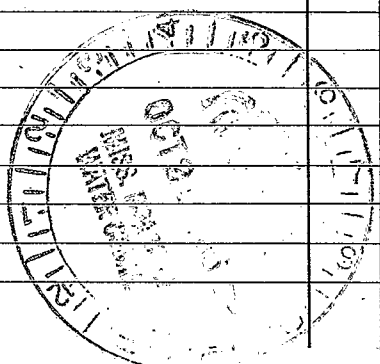

[The page contains extremely faint and illegible text, likely bleed-through from the reverse side of the document. The text is arranged in several columns and paragraphs, but the characters are too light to be transcribed accurately.]