

Monroe
H7
4-67

MISSISSIPPI
BOARD OF WATER COMMISSIONERS
416 North State Street
Jackson, Mississippi 39201

CODED

WATER WELL DRILLERS LOG

4-13 date well completed
1967 W.J. REEVES & SON firm name
MONROE county well located

LANDOWNER: BILLY PARHAM

description of formations encountered

from to

RT. 1 HW 278E

AMORY 256 3435
(mailing address)

RED CLAY	0	20
SAND & GRAVEL	20	22
RED SAND & CLAY	22	70
RED SAND	70	105

WELL LOCATION:


sec. 5 T 13 R 18 S 3
1 miles SE of AMORY
(distance) (direction) (nearest town)

WELL PURPOSE: IND.
(home, irrigation, municipal, industrial)

WELL COMPLETION DATA:

- (1) diameter (inches) 4
- (2) total depth (feet) 105
- (3) static water level (feet) 67 below top of ground.
- (4) casing PVC, 85,
(material) (depth),
4 if telescope see back.
(size)
- (5) screen 20', 85
(length) (depth to top)
4, PVC
(size) (material)
- (6) pump 1 14
(HP) (yield gpm)
ELECT
(type power)
- (7) electric log NO
(yes or no)
(organization running log)
- (8) how well bottom plugged SAND

CODED

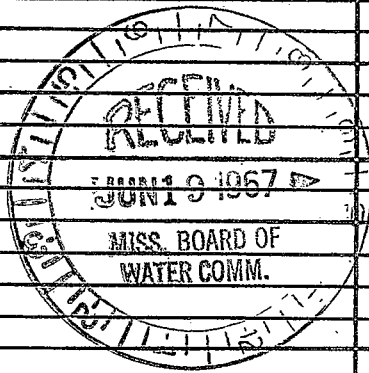


DRILLERS REMARKS:

If well telescopes please sketch and show depths.

GROUND LEVEL

101

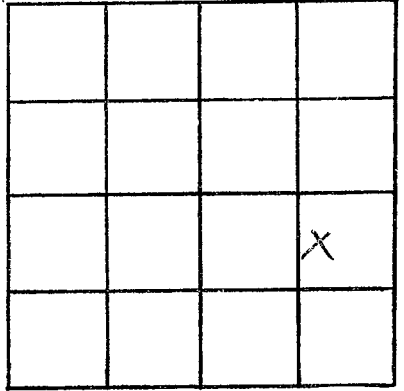

SECTION 5

Please indicate well location X.

ADDITIONAL INFORMATION

If more than one screen, show locations of each on sketch.