

2301

Q 48

11-28-60

ST. LOUIS L. OFF. CL.

**WATER WELL DRILLERS LOG CODED**

Date: 11-28, 1960, Driller: L. J. REEVES & SON County MONROE

623-5 629-10 650-11, 12 (Name)

(1) Owner of Land: J. D. HANEY  
 (Name)  
AMORY, MISS  
 HW 278 E 2562452 (Address)

(2) Location: NW 1/4, NE 1/4, Sec. 6, 10, T13R1B,  
6 miles E, of AMORY  
 (distance) (direction) (Nearest Town)

(3) Topography: HILLY  
 (Hilly) (Flat) (Level)

(4) Purpose of Well: DOMESTIC  
 (Domestic Irrigation  
 Municipal, Industrial, Other)

Description & Color of Materials Sand, Clay, Red Clay, Shell, etc.	Thick- ness Feet	Depth Feet
<u>RED CLAY</u>	<u>17</u>	<u>0</u>
<u>BLUE CLAY</u>	<u>31</u>	<u>17</u>
<u>COARSE WHITE SAND</u>	<u>6</u>	<u>48</u>

Information upon completion of well:

(1) Diameter 4 inches.

(2) Total Depth 54 feet.

(3) Water Level 15 feet below top of ground.

(4) Cased to 49, Size 4


(5) Screen: Size 4, Length 5

(6) Were any formations sealed against pollution?  
       yes,        no.

If YES depth of formation \_\_\_\_\_

Why \_\_\_\_\_

Drillers Remarks: \_\_\_\_\_

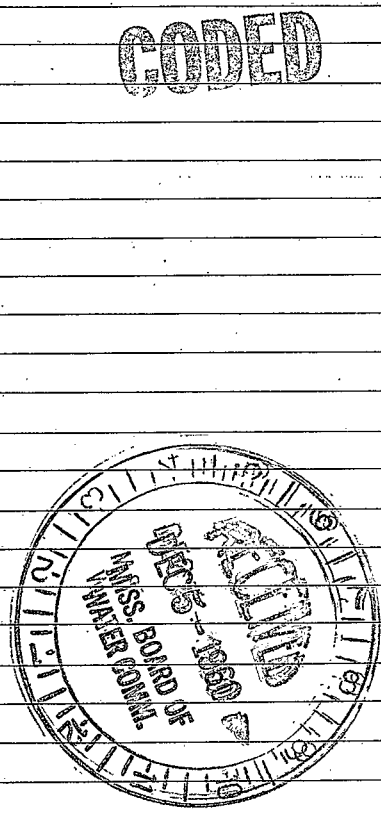

(Use Back Side)

Well No.

