

CODED

MONROE
H10
7-2369

MISSISSIPPI
BOARD OF WATER COMMISSIONERS
416 North State Street
Jackson, Mississippi 39201

WATER WELL DRILLERS LOG

7-23 1969 W.J. REEVES & SON MONROE
date well completed firm name county well located

LANDOWNER: GENE THOMPSON

description of formations encountered

921 So. BLVD.
AMORY
(mailing address)

	from	to
RED CLAY	0	18
GRAY SAND	18	30
BLUE CLAY	30	68
" SAND	68	72
" CLAY	72	91
" SAND	91	94
" CLAY	94	153
GRAY SAND	153	175
BLUE CLAY	175	178

WELL LOCATION:
sec. 14 T. 13 S. R. 18 E.
5 miles SE of AMORY
(distance) (direction) (nearest town)

WELL PURPOSE: STOCK
(home, irrigation, municipal, industrial)

WELL COMPLETION DATA:

- (1) diameter (inches) 4
- (2) total depth (feet) 178
- (3) static water level (feet) 53 below top of ground.
- (4) casing PVC, 158 (depth)
4 (size) if telescope see back.
- (5) screen 20 (length), 158 (depth to top)
4 (size), PVC (material)
- (6) pump 1 (HP), 16 (yield gpm)
ELECT. (type power)
- (7) electric log No (yes or no)

CODED

(organization running log)


(8) how well bottom plugged SAND

DRILLERS REMARKS:

SEP 2 1969
MISS. Bd. of WATER COMMISSIONERS

If well telescopes please sketch and show depths.

GROUND LEVEL

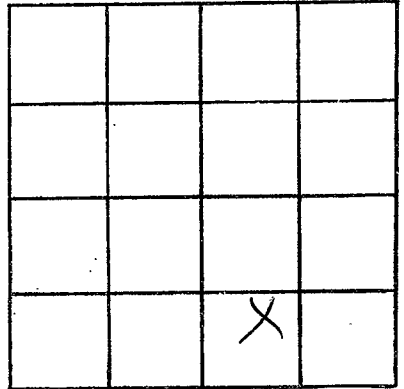

SECTION 14

Please indicate well location X.

ADDITIONAL INFORMATION

If more than one screen, show locations of each on sketch.