

MONROE
H 13
4-22-70

MISSISSIPPI
BOARD OF WATER COMMISSIONERS
416 North State Street
Jackson, Mississippi 39201

CODED

WATER WELL DRILLERS LOG

4-22 1970 W.J. REEVES & SON MONROE
date well completed firm name county well located

LANDOWNER: JESSIE NASH
HV 278 2563396
RT. 2
AMORY
(mailing address)

description of formations encountered	from	to
RED CLAY	0	26
RED SAND & CLAY	26	100
RED SAND	100	132
BLUE CLAY	132	135

WELL LOCATION:
sec. 4 T. 13 R. 18
2 miles E of AMORY
(distance) (direction) (nearest town)

WELL PURPOSE: HOME
(home, irrigation, municipal, industrial)

WELL COMPLETION DATA:

- (1) diameter (inches) 4
- (2) total depth (feet) 135
- (3) static water level (feet) 60 below top of ground.
- (4) casing PVC 115 (material) (depth)
4 (size) if telescope see back.
- (5) screen 20 115 (length) (depth to top)
4 PVC (size) (material)
- (6) pump 1/2 10 (HP) (yield gpm)
ELECT (type power)
- (7) electric log NO (yes or no)
(organization running log)
- (8) how well bottom plugged SAND

CODED


AUG 28 1970

DRILLERS REMARKS:

MISS. BD. OF
WATER COMM.

If well telescopes please sketch and show depths.

GROUND LEVEL

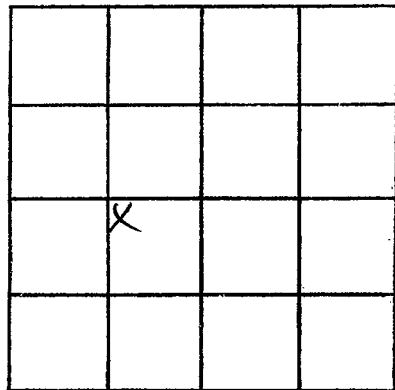

SECTION 4

Please indicate well location X.

ADDITIONAL INFORMATION

If more than one screen, show locations of each on sketch.