

MONROE

H 14

7-7-70

MISSISSIPPI BOARD OF WATER COMMISSIONERS
416 North State Street
Jackson, Mississippi 39201

CODED

WATER WELL DRILLERS LOG

7-7 1970 W.J. REEVES & SON MONROE
date well completed firm name county well located

LANDOWNER: DICK MILBENDER

AMORY

Highland Cir. 2565620

(mailing address)

WELL LOCATION:

sec. 17 T 13 R 18
3 miles S. of Amory
(distance) (direction) (nearest town)

WELL PURPOSE: STOCK
(home, irrigation, municipal, industrial)

WELL COMPLETION DATA:

- (1) diameter (inches) 4
- (2) total depth (feet) 70
- (3) static water level (feet) 12 below top of ground.
- (4) casing PVC 50 (material) (depth)
4 (size) if telescope see back.
- (5) screen 20 50 (length) (depth to top)
4 PVC (size) (material)
- (6) pump 3/4 20 (HP) (yield gpm)
ELECT (type power)
- (7) electric log No (yes or no)
- (8) how well bottom plugged SAND

description of formations encountered

from to

| | | |
|---------------|----|----|
| CLAY | 0 | 15 |
| SAND & GRAVEL | 15 | 21 |
| BLUE CLAY | 21 | 38 |
| " SAND | 38 | 70 |

CODED


DRILLERS REMARKS:

AUG 26 1970

MISS. DEPT. OF WATER CONTROL

If well telescopes please sketch and show depths.

GROUND LEVEL

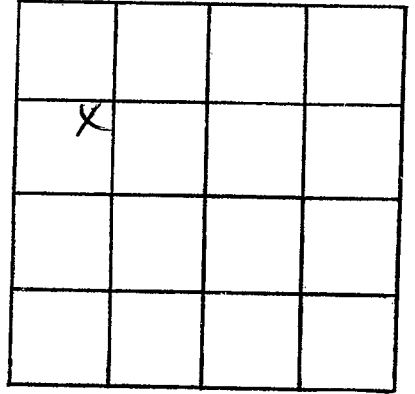

SECTION 17

Please indicate well location X.

ADDITIONAL INFORMATION

If more than one screen, show locations of each on sketch.