

MISSISSIPPI  
BOARD OF WATER COMMISSIONERS  
416 North State Street  
Jackson, Mississippi 39201

**CODED**

**WATER WELL DRILLERS LOG**

**MONROE**  
**H15**  
**1-18-73**

1-18 1973 W. J. REEVES & SON MONROE  
date well completed firm name county well located

LANDOWNER: H. G. VICKREY

PT 2

ABERDEEN

(mailing address)

WELL LOCATION:

sec. 26 T. 13 N R. 18 E  
S W  
6 miles SE of AMORY  
(distance) (direction) (nearest town)

WELL PURPOSE: HOME  
(home, irrigation, municipal, industrial)

WELL COMPLETION DATA:

- (1) diameter (inches) 4
- (2) total depth (feet) 106
- (3) static water level (feet) 49 below above top of ground.
- (4) casing PVC, 86  
(material) (depth)  
4 if telescope see back.  
(size)
- (5) screen 20, 86  
(length) (depth to top)  
4, PVC  
(size) (material)
- (6) pump 1/2, 10  
(HP) (yield gpm)  
ELECT  
(type power)
- (7) electric log NO  
(yes or no)

(organization running log)

(8) how well bottom plugged WOOD

description of formations encountered

from to

CLAY 0 23  
RD. SAND 23 104  
BOOE CLAY 104 106

**CODED**


SEE 1-18-73  
PAGE 1 OF 1

MISS. OF  
WATER

DRILLERS REMARKS:

If well telescopes please sketch and show depths.

GROUND LEVEL

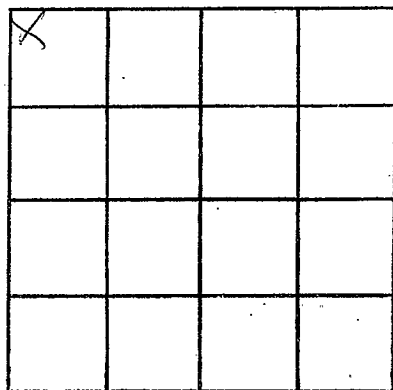

SECTION 26

Please indicate well location X.

ADDITIONAL INFORMATION

If more than one screen,  
show locations of each on sketch.