

MONROE
H 16
2-15-73

MISSISSIPPI
BOARD OF WATER COMMISSIONERS
416 North State Street
Jackson, Mississippi 39201

CODED


WATER WELL DRILLERS LOG

2-15 1973 W. J. REEVES & SON MONROE
date well completed firm name county well located

LANDOWNER: <u>FIRST AMERICAN</u>	Description of formations encountered	from	to
RT. 1			
Amory (mailing address)	CLAY GREY SAND	0 17	17 38
WELL LOCATION: sec. <u>14</u> T. <u>13</u> S. R. <u>18</u> W. E. <u>2</u> miles <u>SO</u> of <u>AMORY</u> (distance) (direction) (nearest town)			
WELL PURPOSE: <u>HOME</u> (home, irrigation, municipal, industrial)			
WELL COMPLETION DATA:			
(1) diameter (inches) <u>2</u>			
(2) total depth (feet) <u>38</u>			
(3) static water level (feet) <u>8</u> below top of ground.			
(4) casing <u>PVC</u> , <u>30</u> (material) (depth) <u>2</u> if telescope see back. (size)	CODED		
(5) screen <u>8</u> , <u>30</u> (length) (depth to top)			
(6) pump <u>2</u> , <u>PVC</u> (size) (material)			
(6) pump _____ (HP) (yield gpm) (type power)			
(7) electric log <u>No</u> (yes or no)			
(7) _____ (organization running log)			
(8) how well bottom plugged <u>WOOD</u>			
DRILLERS REMARKS:	MAY 9 1973		

If well telescopes please
sketch and show depths.

GROUND LEVEL

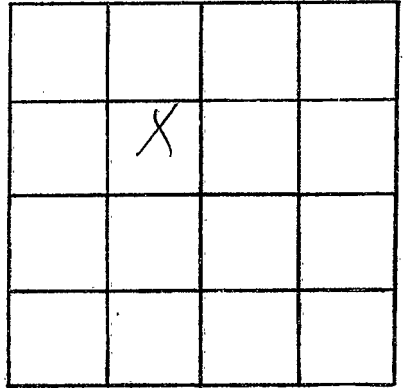

SECTION 14

Please indicate well location X.

ADDITIONAL INFORMATION

If more than one screen,
show locations of each on sketch.