


Monroe
H 2000
11-24-75

MISSISSIPPI
 BOARD OF WATER COMMISSIONERS
 416 North State Street
 Jackson, Mississippi 39201

WATER WELL DRILLERS LOG


11-24 1976 W J REEBER & SON MONROE
 date well completed firm name county well located

LANDOWNER: <u>CHARLES SANDERSON</u>	description of formations encountered	from	to
<u>RT. 2</u> <u>HAOK V</u> (mailing address)			
WELL LOCATION: sec. <u>2</u> T. <u>13</u> N. R. <u>18</u> E <u>2</u> miles <u>SE</u> of <u>HATLEY</u> (distance) (direction) (nearest town)	<u>RED CLAY</u>	<u>0</u>	<u>24</u>
WELL PURPOSE: <u>HOME</u> (home, irrigation, municipal, industrial)	<u>RED CLAY & SAND</u>	<u>24</u>	<u>70</u>
WELL COMPLETION DATA:	<u>RED SAND</u>	<u>70</u>	<u>78</u>
(1) diameter (inches) <u>4</u>	<u>RED CLAY & SAND</u>	<u>78</u>	<u>100</u>
(2) total depth (feet) <u>240</u>	<u>BLUE CLAY</u>	<u>100</u>	<u>195</u>
(3) static water level (feet) <u>105</u> below top of ground.	<u>WHITE SAND</u>	<u>195</u>	<u>240</u>
(4) casing <u>PVC</u> , <u>220</u> , (material) (depth) <u>4</u> if telescope see back. (size)			
(5) screen <u>20</u> , <u>220</u> (length) (depth to top) <u>4</u> , <u>PVC</u> (size) (material)			
(6) pump <u>1</u> , <u>12</u> (HP) (yield gpm)			
(7) electric log <u>NO</u> (yes or no)			
(8) how well bottom plugged <u>SAND</u>			
DRILLERS REMARKS:			

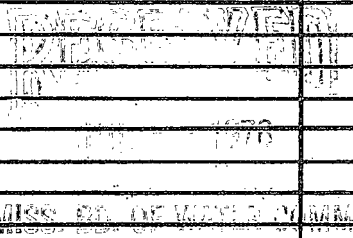

If well telescopes please sketch and show depths.

GROUND LEVEL

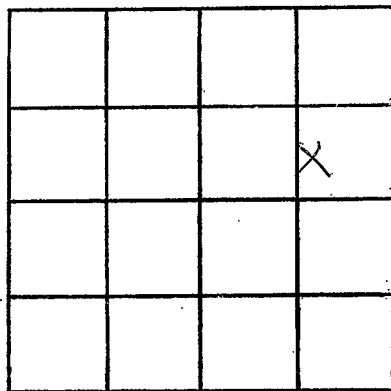

SECTION 2

Please indicate well location X.

ADDITIONAL INFORMATION

If more than one screen,
show locations of each on sketch.