

MISSISSIPPI DEPARTMENT OF ENVIRONMENTAL QUALITY
Bureau of Land and Water Resources

P. O. Box 10631
Jackson, MS 39289-0631
WATER WELL DRILLERS LOG

COUNTY WELL LOCATED
Monroe

WELL NUMBER H 2905 CODED

DATE WELL COMPLETED
9/5/92

PERMIT NUMBER

NAME OF DRILLING FIRM
Rossi Drilling

NAME & MAILING ADDRESS OF LANDOWNER
Randy Minor
Kimbrough Rd.
Amory MS 38821

WELL LOCATION: SEC 15 TOWNSHIP N 135 RANGE 18 E

DISTANCE 10 Miles DIRECTION 278E of NEAREST TOWN Amory

OTHER LANDMARK
1 1/2 miles on Kimbrough Rd

WELL PURPOSE: Home Irrigation, Municipal, Industrial, Fish Pond, etc.

PUMP DATA

PUMP TYPE (Circle One):
 Submersible, Turbine, Jet, Flowing Well,
Other (Describe) _____

POWER TYPE (Circle One):
 Electric, Tractor, Diesel, Gasoline, Butane,
Other (Describe) _____ H/P 50

Pump Capacity (GPM) 12 No. of Stages _____ Setting Depth 164' FT.

~~PUMP TEST~~

~~Well yielded _____ GPM with~~

~~a drawdown of _____ ft.~~

~~after _____ hours of pumping~~

WELL DATA

Well Depth <u>112'</u>	Casing Diameter (In.) <u>4"</u>	Casing Length (Ft.) <u>102'</u>
Type of Casing <u>PVC</u>	Hole Depth <u>112'</u>	Depth to Static Water Level <u>48'</u>

TYPE OF COMPLETION: (Circle One or More):
 Gravel Packed, Underreamed, Telescoped,
 Natural Development, Open Hole, Other
(Describe) _____

Top of Lap Pipe or Reduction in Casing
FEET IF TELESCOPED OR MORE THAN ONE SCREEN: USE BACK PAGE

LOG DATA

TYPE OF LOG RUN (Circle One):
 No Log Run, Electric, Gamma Ray, Density, Sonic, Neutron,
Other (Describe) None

Name of Organization Running Log _____

SCREEN DATA

Diameter - Inches <u>4"</u>	Length - Feet <u>10'</u>	Slot Size - Inches <u>10/13</u>
Screen Type <u>PVC</u>	Depth to Bottom - Feet <u>10'</u>	

GEOLOGIC DATA (Office Use Only)

Surface Elev.	Geologic Unit	Unit Thickness	Depth to Top
Subs. SWL	Date	Analysis	Aquifer Test

Driller's Remarks

DESCRIPTION OF FORMATIONS ENCOUNTERED	FROM	TO
<u>clay</u>	<u>0</u>	<u>38</u>
<u>sandy clay strips</u>	<u>38</u>	<u>60</u>
<u>sandy clay strips</u>	<u>60</u>	<u>112</u>
<u>Bottom Blue clay</u>		

FORMATIONS (Continued)

RECEIVED

JUN 08 1993

Dept. of Environmental Quality
Office of Land & Water Resources


IF MORE SPACE IS NEEDED, USE BACK

If well telescopes please sketch and show depths.

GROUND LEVEL

R 8 E

T135

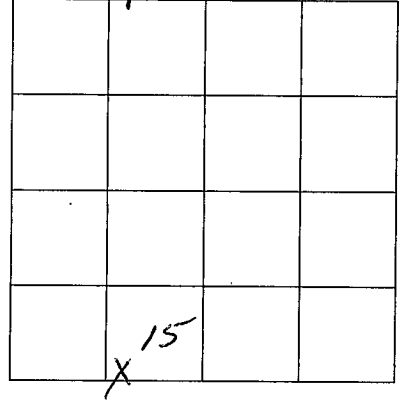

SECTION 15

Please indicate well location X.

ADDITIONAL INFORMATION

If more than one screen,
show location of each on sketch.