

MONROE
J2
2-4-71

MISSISSIPPI
BOARD OF WATER COMMISSIONERS
416 North State Street
Jackson, Mississippi 39201

CODED

WATER WELL DRILLERS LOG

2-4 1971 W.J. REEVES & SON MONROE
date well completed firm name county well located

LANDOWNER: POINCY WATER ASSN
GREENWOOD SPRINGS
(mailing address)

description of formations encountered	from	to
RED CLAY	0	22
RED SAND & CLAY	22	107
BLUE CLAY	107	158
" SAND	158	173
" CLAY	173	241
" CLAY & SAND	241	270
" CLAY	270	308
" SAND	308	316
" CLAY	316	380
SAND & GRAVEL	380	424

WELL LOCATION:
sec. 30 T. 13 S. R. 9 E.
8 miles SE of Amory
(distance) (direction) (nearest town)

WELL PURPOSE: MUN.
(home, irrigation, municipal, industrial)

- WELL COMPLETION DATA:
- (1) diameter (inches) 4
 - (2) total depth (feet) 424
 - (3) static water level (feet) 195 below top of ground.
 - (4) casing PVC 404
(material) (depth)
4 if telescopes see back.
(size)
 - (5) screen 20' 404
(length) (depth to top)
4" PVC
(size) (material)
 - (6) pump 5 45
(HP) (yield gpm)
ELECT.
(type power)
 - (7) electric log No
(yes or no)
(organization running log)
 - (8) how well bottom plugged VALVE

CODED


MAR 16 1971

MISS. BD. OF
WATER COMMISSIONERS

DRILLERS REMARKS:
CEMENT CROOT - 0'-380'

If well telescopes please sketch and show depths.

GROUND LEVEL

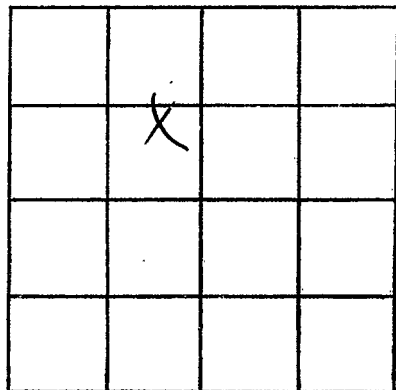

SECTION 30

Please indicate well location X.

ADDITIONAL INFORMATION

If more than one screen, show locations of each on sketch.