

ELOG #52

CODED

CODED

MISSISSIPPI BOARD OF WATER COMMISSIONERS
416 North State Street
Jackson, Mississippi 39201

WATER WELL DRILLERS LOG

Monroe
J 10
7-7-67

7-7-1967 date well completed. Layne-Central Company firm name Monroe county well located

LANDOWNER:

Village of Gattman

Gattman, Mississippi
(mailing address)

description of formations encountered

from to

Clay	31	31
sand and gravel	58	27
clay	64	6
sand	101	37
clay	106	5
sand and gravel	124	18

WELL LOCATION:

sec. 32 T 13 N R 10 E 16W
NESE S W


(distance) miles (direction) of (nearest town)

WELL PURPOSE: municipal
(home, irrigation, municipal, industrial)

WELL COMPLETION DATA:

- (1) diameter (inches) 18"
- (2) total depth (feet) 128'
- (3) static water level (feet) 19' below top of ground.
- (4) casing s. welded 104', (material) (depth), 8" (size) if telescope see back.
- (5) screen 20' (length), 104' (depth to top), 6" (size), s. s. shutter (material)
- (6) pump 7-1/2 (HP), 110 (yield gpm), electric (type power)
- (7) electric log (yes or no)
- (organization running log)
- (8) how well bottom plugged


CODED

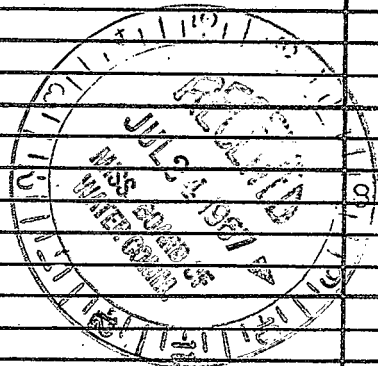

DRILLERS REMARKS:

If well telescopes please sketch and show depths.

GROUND LEVEL

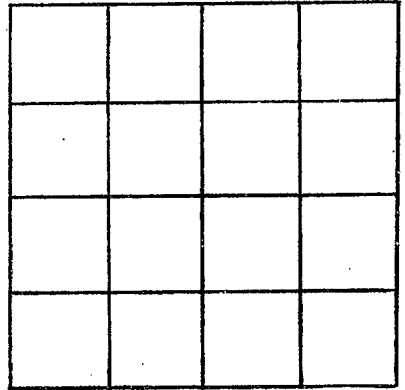

SECTION 32

Please indicate well location X.

ADDITIONAL INFORMATION

If more than one screen, show locations of each on sketch.