

MONROE

MISSISSIPPI BOARD OF WATER COMMISSIONERS

QJ 11
5-15-61

WATER WELL DRILLERS LOG

CODED

Date: 6-15, 1961, Driller: J.C. REEVES County MONROE

617-3 Z HD ON RT
(Name)

H W 278
256 346B

(1) Owner of Land: GUY FOWLER
(Name)
AMORY, MISS,
(Address)

Description & Color of Materials Sand, Clay, Red Clay, Shell, etc.	Thick- ness Feet	Depth Feet
<u>CLAY</u>	<u>12</u>	<u>0</u>
<u>RED SAND</u>	<u>36</u>	<u>12</u>

(2) Location: SE 1/4, SE 1/4, Sec. 32 T13R16W
_____ miles _____ of CATMAN
(distance) (direction) (Nearest Town)

(3) Topography: FLAT
(Hilly) (Flat) (Level)

(4) Purpose of Well: INDUSTRIAL
(Domestic Irrigation
Municipal, Industrial, Other)


Information upon completion of well:

- (1) Diameter 2 inches. NOT IN USE
ON WATER SYS
- (2) Total Depth 48 feet.
- (3) Water Level 12 feet below top of ground.
- (4) Cased to 43, Size 2"
- (5) Screen: Size 2", Length 5'
- (6) Were any formations sealed against pollution?
_____ yes, _____ no.

CODED

If YES depth of formation _____
Why _____

Drillers Remarks: _____

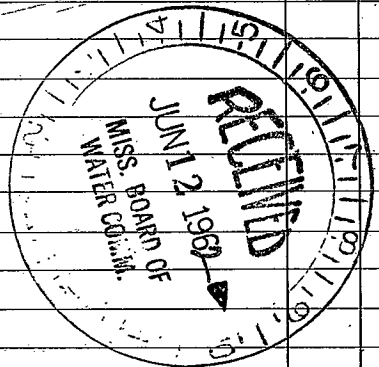

(Use Back Side)

Well No.

