

CODED

MISSISSIPPI
BOARD OF WATER COMMISSIONERS
416 North State Street
Jackson, Mississippi 39201

WATER WELL DRILLERS LOG

MONROE
J 12
2-6-69

2-6 1969 W. J. REEVES & SON MONROE
date well completed firm name county well located

LANDOWNER: J. H. MINCA

description of formations encountered

from to

GREENWOOD SPRINGS

RED CLAY 0 22

" SAND 22 65

" CLAY + SD STRKS. 65 91

BLUE CLAY 91 151

BLUE CLAY + SD - SLIPY 151 160

" CLAY 160 250

SAND & GRAVEL 250 286

(mailing address)

WELL LOCATION:

sec. 2 T 13 R 10 E
S S #
10 miles E of AMORY
(distance) (direction) (nearest town)

WELL PURPOSE: HOME
(home, irrigation, municipal, industrial)

WELL COMPLETION DATA:

(1) diameter (inches) 4

(2) total depth (feet) 286

(3) static water level (feet) 183 below top of ground.

(4) casing STEEL, 276 (material) (depth)

4 (size) If telescope see back.

(5) screen 10', 276 (length) (depth to top)

22 STAINLESS ON ADV. PIPE (size) (material)

(6) pump 1 (HP) 15 (yield gpm)

ELECT (type power)

(7) electric log No (yes or no)

(organization running log)

(8) how well bottom plugged VALVE


DRILLERS REMARKS:

JUN 23 1969

MISS. BIL. OF WATER CONTROL

If well telescopes please sketch and show depths.

GROUND LEVEL

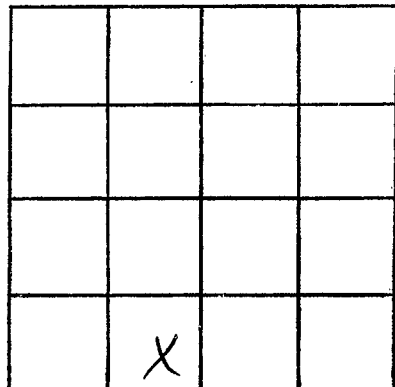

SECTION 2

Please indicate well location X.

ADDITIONAL INFORMATION

If more than one screen, show locations of each on sketch.