

MONROE
 J 13
 7-4-70

MISSISSIPPI
 BOARD OF WATER COMMISSIONERS
 416 North State Street
 Jackson, Mississippi 39201

CODED

WATER WELL DRILLERS LOG

7-4 1970 W.J. REEVES & SON MONROE
 date well completed firm name county well located

LANDOWNER: H.R. HALL
GREENWOOD SPRINGS
 (mailing address)

description of formations encountered	from	to
RED CLAY	0	22
" SAND	22	87
BLUE CLAY	37	183
" SAND	183	199
" CLAY	199	230
WHITE SAND	230	268

WELL LOCATION:
 sec. 8 T. 13 R. 9E
8 miles E of AMORY
 (distance) (direction) (nearest town)

WELL PURPOSE: HOME
 (home, irrigation, municipal, industrial)

WELL COMPLETION DATA:
 (1) diameter (inches) 4
 (2) total depth (feet) 268
 (3) static water level (feet) 173 below top of ground.
 (4) casing PVC 248
 (material) (depth)
4 if telescope see back.
 (size)
 (5) screen 20 248
 (length) (depth to top)
4 PVC
 (size) (material)
 (6) pump 1 1/2 20
 (HP) (yield gpm)
ELECT
 (type power)
 (7) electric log NO
 (yes or no)
 (organization running log)
 (8) how well bottom plugged SAND

CODED


AUG 20 1970

MISS. Bd. OF
 WATER COMM.

DRILLERS REMARKS:

If well telescopes please sketch and show depths.

GROUND LEVEL

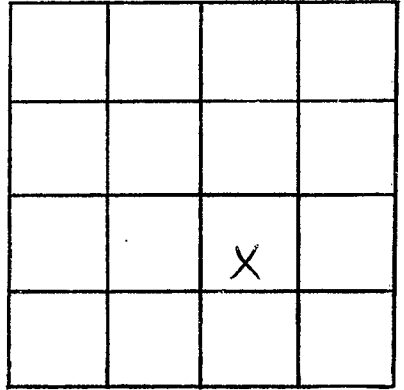

SECTION 2

Please indicate well location X.

ADDITIONAL INFORMATION

If more than one screen, show locations of each on sketch.