

MONROE
J14
7-12-72

MISSISSIPPI
BOARD OF WATER COMMISSIONERS
416 North State Street
Jackson, Mississippi 39201

CODED

WATER WELL DRILLERS LOG

7-12 1972 W. J. REEVES & SON MONROE
date well completed firm name county well located

LANDOWNER: D. L. BROWN
RT. 2

description of formations encountered	from	to

CREEKWOOD SPRINGS
(mailing address)

CLAY	0	22
SAND & GRAVEL	22	61

WELL LOCATION:
sec. 19 T. 13 S. R. 16 E. of AMORY
12 miles (distance) E (direction) (nearest town)

WELL PURPOSE: HOME
(home, irrigation, municipal, industrial)

WELL COMPLETION DATA:

- (1) diameter (inches) 4
- (2) total depth (feet) 61
- (3) static water level (feet) 18 below above top of ground.
- (4) casing PVC 41
(material) (depth)
4 if telescope see back.
(size)
- (5) screen 20 41
(length) (depth to top)
4 PVC
(size) (material)
- (6) pump 1/2 6
(HP) (yield gpm)
ELECT
(type power)
- (7) electric log NO
(yes or no)

(organization running log)
- (8) how well bottom plugged SAND

CODED



NOV 14 1972

DRILLERS REMARKS:

MISS. BD. OF
WATER COMMISSIONERS

If well telescopes please sketch and show depths.

GROUND LEVEL

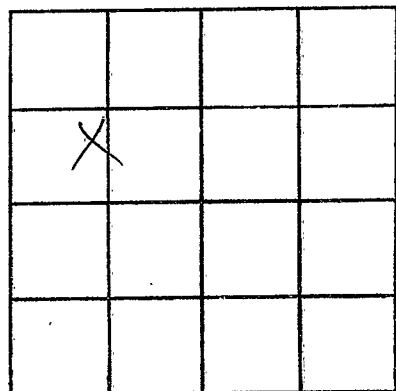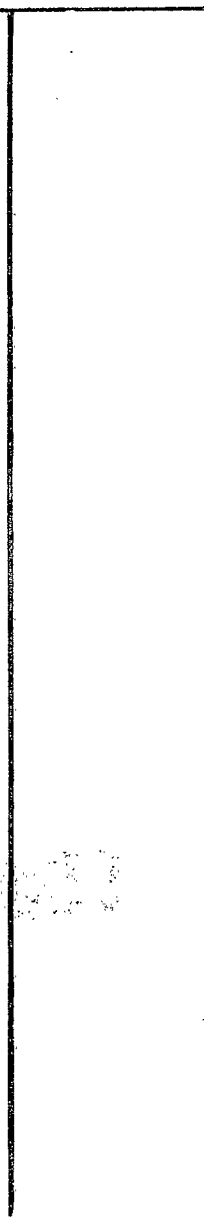

SECTION 19

Please indicate well location X.

ADDITIONAL INFORMATION

If more than one screen, show locations of each on sketch.