

MONROE
J 15
7-29-72

MISSISSIPPI
BOARD OF WATER COMMISSIONERS
416 North State Street
Jackson, Mississippi 39201

WATER WELL DRILLERS LOG

7-29 1972 W. J. REEVES & SON MONROE
date well completed firm name county well located

LANDOWNER: COY CARTER
RT. 2

description of formations encountered	from to	
	ft	ft
<u>RED CLAY</u>	<u>0</u>	<u>24</u>
<u>RED SAND</u>	<u>24</u>	<u>94</u>
<u>BOVE CLAY</u>	<u>94</u>	<u>96</u>

GREENWOOD SPRINGS
(mailing address)

WELL LOCATION:
sec. 32 T. 13 N R. 17 E
9 miles SE of AMORY
(distance) (direction) (nearest town)

WELL PURPOSE: HOMEP
(home, irrigation, municipal, industrial)

- WELL COMPLETION DATA:
- (1) diameter (inches) 4
 - (2) total depth (feet) 96
 - (3) static water level (feet) 64 below top of ground.
 - (4) casing PVC, 76 (material), (depth)
4 (size) if telescope see back.
 - (5) screen 20, 76 (length), (depth to top)
4 (size), PVC (material)
 - (6) pump 1/2, 10 (HP), (yield gpm)
ELECT. (type power)
 - (7) electric log NO (yes or no)
 - (organization running log)
 - (8) how well bottom plugged SAND


NOV 17 1972

DRILLERS REMARKS:

APPROVED: _____
DISPATCHED: _____
CHECKED: _____
DATE: _____

If well telescopes please sketch and show depths.

GROUND LEVEL

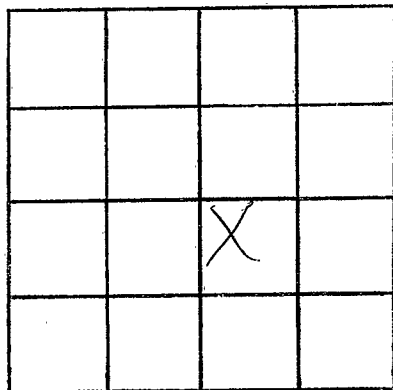

SECTION 32

Please indicate well location X.

ADDITIONAL INFORMATION

If more than one screen,
show locations of each on sketch.