

MONROE
J 16
1-15-73

MISSISSIPPI
BOARD OF WATER COMMISSIONERS
416 North State Street
Jackson, Mississippi 39201

CODED

WATER WELL DRILLERS LOG

1-15 1973 W. J. REEVES & SON MONROE
date well completed firm name county well located

LANDOWNER: JOHN HAWKINS

description of formations encountered

from to

RT 2

ABERDEEN
(mailing address)

CLAY	0	19
RD. SAND + CLAY	19	100
BLUE CLAY	100	102

WELL LOCATION:

sec 26 T 13 N R 17 W S 7
(distance) miles SE of AMORY
(direction) (nearest town)

WELL PURPOSE: HOME
(home, irrigation, municipal, industrial)

WELL COMPLETION DATA:

- (1) diameter (inches) 4
- (2) total depth (feet) 102
- (3) static water level (feet) 102 below top of ground.
- (4) casing PVC, 82 (material), (depth)
4 (size) if telescope see back.
- (5) screen 20, 82 (length), (depth to top)
4, PVC (size), (material)
- (6) pump 1, 6 (HP), (yield gpm)
ELECT (type power)
- (7) electric log No (yes or no)
(organization running log)
- (8) how well bottom plugged WOOD

CODED


FEB 11 1973

DRILLERS REMARKS:

MISS. D.
WELL

If well telescopes please sketch and show depths.

GROUND LEVEL

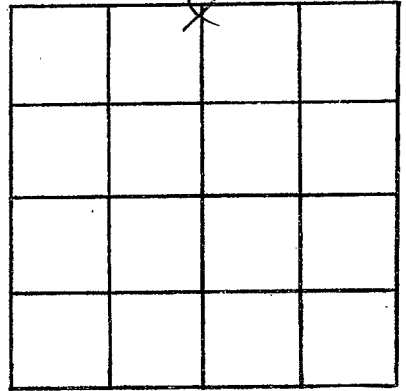

SECTION 26

Please indicate well location X.

ADDITIONAL INFORMATION

If more than one screen, show locations of each on sketch.