

MONROE
J17
4-17-74

MISSISSIPPI
 BOARD OF WATER COMMISSIONERS
 416 North State Street
 Jackson, Mississippi 39201

WATER WELL DRILLERS LOG **CODED**

4-17 date well completed 1974 W. J. REEVES & SON firm name MONROE county well located

LANDOWNER: COUNTY SCHOOL
GREENWOOD SPRINGS
 (mailing address)

description of formations encountered	from	to
CLAY	0	21
SAND & GRAVEL	21	35
BLUE CLAY	35	75
SAND & GRAVEL	75	120


WELL LOCATION:
 sec. 34 T 13 S R. 17 W
10 miles SE of ANDRY
 (distance) (direction) (nearest town)

WELL PURPOSE: SCHOOL
 (home, irrigation, municipal, industrial)

- WELL COMPLETION DATA:
- (1) diameter (inches) 4
 - (2) total depth (feet) 120
 - (3) static water level (feet) 66 below/above top of ground.
 - (4) casing PVC, 100,
 (material) (depth)
4 If telescope see back.
 (size)
 - (5) screen 20, 100
 (length) (depth to top)
4, PVC
 (size) (material)
 - (6) pump 1, 20
 (HP) (yield gpm)
ELECT
 (type power)
 - (7) electric log NO
 (yes or no)
- (organization running log)
- (8) how well bottom plugged SAND

DRILLERS REMARKS:


CODED

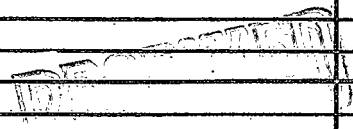

MISS. Bd. of Water Comm. DIVISION

If well telescopes please sketch and show depths.

GROUND LEVEL

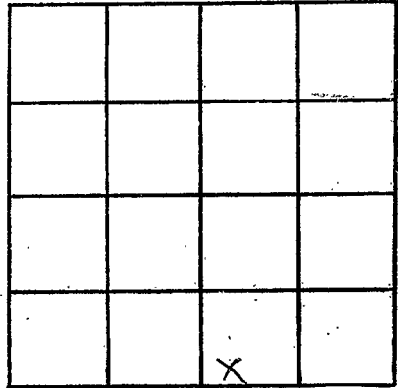

SECTION 34

Please indicate well location X.

ADDITIONAL INFORMATION

If more than one screen,
show locations of each on sketch.