

**MONROE**  
**J18**  
**1-8-74**

MISSISSIPPI  
 BOARD OF WATER COMMISSIONERS  
 416 North State Street  
 Jackson, Mississippi 39201

CODED

WATER WELL DRILLERS LOG

1-8 1974 W. J. REEVES 2 SON MONROE  
 date well completed firm name county well located

LANDOWNER: SID THORN  
GREEN WOOD SPRINGS  
 (mailing address)

description of formations encountered	from	to
CLAY	0	16
WHITE SAND	16	22
BLUE CLAY	22	80
SAND & GRAVEL	80	120

WELL LOCATION:  
 sec. 13 T. 13 N. R. 17 E.  
11 miles E of AMORY  
 (distance) (direction) (nearest town)

WELL PURPOSE: HOME  
 (home, irrigation, municipal, industrial)

- WELL COMPLETION DATA:
- (1) diameter (inches) 4
  - (2) total depth (feet) 120
  - (3) static water level (feet) 82 below/above top of ground.
  - (4) casing PVC, 100,  
 (material) (depth)  
4 if telescope see back.  
 (size)
  - (5) screen 20, 100  
 (length) (depth to top)  
4, PVC  
 (size) (material)
  - (6) pump 1/2, 8  
 (HP) (yield gpm)  
ELECT  
 (type power)
  - (7) electric log No  
 (yes or no)
  - (organization running log)
  - (8) how well bottom plugged SAND


CODED

DRILLERS REMARKS:

MISSISSIPPI BOARD OF WATER COMMISSIONERS  
 JACKSON, MISSISSIPPI

If well telescopes please sketch and show depths.

GROUND LEVEL

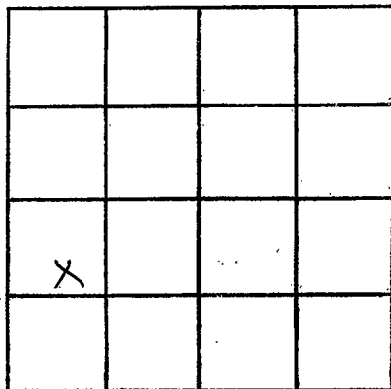

SECTION 13

Please indicate well location X.

ADDITIONAL INFORMATION

If more than one screen,  
show locations of each on sketch.