

MON ROE
 J19
 1-18-74

MISSISSIPPI
 BOARD OF WATER COMMISSIONERS
 416 North State Street
 Jackson, Mississippi 39201

CODED

WATER WELL DRILLERS LOG

1-18 1974 N. J. REEVES & SON MON ROE
 date well completed firm name county well located

LANDOWNER: MARIO ORTIZ
 GREENWOOD SPRINGS
 (mailing address)

description of formations encountered	from	to
RED CLAY	0	24
BLUE CLAY	24	78
SAND & GRAVEL	78	120

WELL LOCATION:
 sec. 13 T. 13 N R. 17 E
 S W
 11 miles E of AMORY
 (distance) (direction) (nearest town)

WELL PURPOSE: HOME
 (home, irrigation, municipal, industrial)

- WELL COMPLETION DATA:
- (1) diameter (inches) 4
 - (2) total depth (feet) 120
 - (3) static water level (feet) 74 below above top of ground.
 - (4) casing PVC, 120 (material) (depth)
 4 (size) if telescope see back.
 - (5) screen 20, 100 (length) (depth to top)
 4, PVC (size) (material)
 - (6) pump 1/2, 8 (HP) (yield gpm)
 SUBOT (type power)
 - (7) electric log NO (yes or no)
 (organization running log)
 - (8) how well bottom plugged SAND

DRILLERS REMARKS:


CODED

RECEIVED
 JUN 16 1974

60118

If well telescopes please sketch and show depths.

GROUND LEVEL

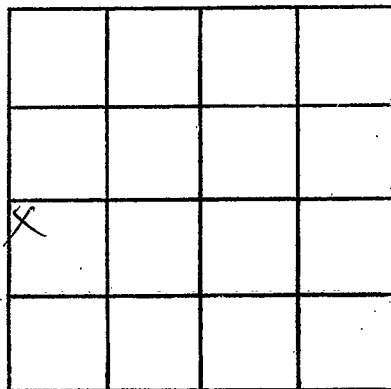

SECTION 13

Please indicate well location X.

ADDITIONAL INFORMATION

If more than one screen,
show locations of each on sketch.