

MONROE
J 20
1-29-74

MISSISSIPPI
 BOARD OF WATER COMMISSIONERS
 416 North State Street
 Jackson, Mississippi 39201

CODED

WATER WELL DRILLERS LOG

1-29 1974 W. J. REEVES & SON MONROE
 date well completed firm name county well located

LANDOWNER: DAVERN ARRANT
GREENWOOD SPRINGS
 (mailing address)

description of formations encountered	from	to
	CLAY	0
RED SAND	20	137
BLUE CLAY	137	140

WELL LOCATION:
 sec 32 T 13 N R 17 E
 S W
10 miles SE of ADORY
 (distance) (direction) (nearest town)

WELL PURPOSE: HOME
 (home, irrigation, municipal, industrial)

CODED


- WELL COMPLETION DATA:
- (1) diameter (inches) 4
 - (2) total depth (feet) 140
 - (3) static water level (feet) 94 below top of ground.
 - (4) casing PVC, 120,
 (material) (depth)
4 If telescope see back.
 (size)
 - (5) screen 20, 120
 (length) (depth to top)
4, PVC
 (size) (material)
 - (6) pump 1/2, 8
 (HP) (yield gpm)
ELECT
 (type power)
 - (7) electric log No
 (yes or no)
- (organization running log)
- (8) how well bottom plugged SAND

DRILLERS REMARKS:

MISSISSIPPI
 BOARD OF WATER COMMISSIONERS
 J. W. REEVES & SON
 MISS. B.L. 01

If well telescopes please sketch and show depths.

GROUND LEVEL

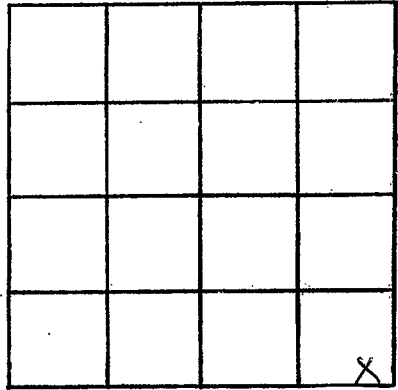

SECTION 32

Please indicate well location X.

ADDITIONAL INFORMATION

If more than one screen, show locations of each on sketch.