

J-21

|         |
|---------|
| MONROE  |
| J       |
| 3-31-78 |

MISSISSIPPI  
BOARD OF WATER COMMISSIONERS  
416 North State Street  
Jackson, Mississippi 39201

WATER WELL DRILLERS LOG

3-31 19 78 Leaper Monroe  
date well completed firm name county well located

LANDOWNER: Bobby Wilmon  
301 S. 4th St. Amory  
(mailing address)

| description of formations encountered | from | to   |
|---------------------------------------|------|------|
| White Dirt                            | 0    | 20'  |
| Red sand                              | 20'  | 60'  |
| Blue clay                             | 60'  | 120' |
| Chalk & rock                          | 120' | 260' |
| Sand                                  | 260' | 317' |

WELL LOCATION:  
sec 21 T 13 N R 9 E  
10 miles E of Amory  
(distance) (direction) (nearest town)

WELL PURPOSE: Home  
(home, irrigation, municipal, industrial)

WELL COMPLETION DATA:

(1) diameter (inches) 4

(2) total depth (feet) 317

(3) static water level (feet) 90 below above top of ground.

(4) casing Plastic, 307,  
(material) (depth)  
(size) If telescope see back.

(5) screen 10', 307'  
(length) (depth to top)  
4", Plastic  
(size) (material)

(6) pump 1 HP, 15  
(HP) (yield gpm)  
Elec.  
(type power)

(7) electric log No  
(yes or no)  
(organization running log)

(8) how well bottom plugged back  
wash valve


DRILLERS REMARKS:

RECEIVED  
AUG 29 1978

MISS. Bd. OF WATER COMMISSIONERS

If well telescopes please sketch and show depths.

GROUND LEVEL

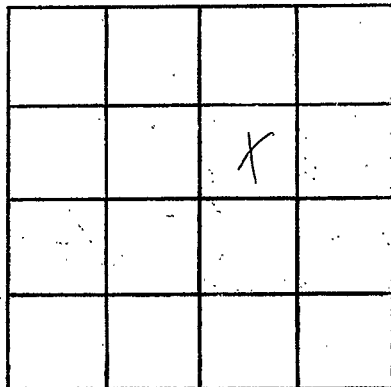

SECTION 21

Please indicate well location X.

ADDITIONAL INFORMATION

If more than one screen, show locations of each on sketch.