

J22
 MONROE
 Elev # 111
 12-6-79

MISSISSIPPI
 BOARD OF WATER COMMISSIONERS
 416 North State Street
 Jackson, Mississippi 39201

CODED

WATER WELL DRILLERS LOG

12-6 1979 Lipe Well Co. Monroe
 date well completed firm name county well located

LANDOWNER: GAO1814
 QUINCY Water ASSN.
 A Mory Ms.
 (mailing address)

description of formations encountered	from	to
Top soil	0	20
red sand	20	100
Clay	100	160
sand and clay	160	200
sand	200	320
ir	320	380
sand and pea gravel	380	440

WELL LOCATION:
 sec. 30 T 13 N R 17 E
 6 miles East of A Mory
 (distance) (direction) (nearest town)

WELL PURPOSE:
 (home, irrigation, municipal, industrial)

WELL COMPLETION DATA:

(1) diameter (inches) 6"
 (2) total depth (feet) 438
 (3) static water level (feet) 200 below top of ground.
 (4) casing Steel 4 1/2" (material) (depth) 6" (size) If telescope see back.
 (5) screen 41" 409 (length) (depth to top) 4 S.S. (size) (material)
 (6) pump 5 80 (HP) (yield gpm) elec. (type power)
 (7) electric log Yes (yes or no) No (organization running log)
 (8) how well bottom plugged Wash valve

CODED

DEPT. OF NATURAL RESOURCES
 BUREAU OF LAND & WATER RESOURCES

JAN 22 1980


RECEIVED

DRILLERS REMARKS:

④

If well telescopes please sketch and show depths.

GROUND LEVEL

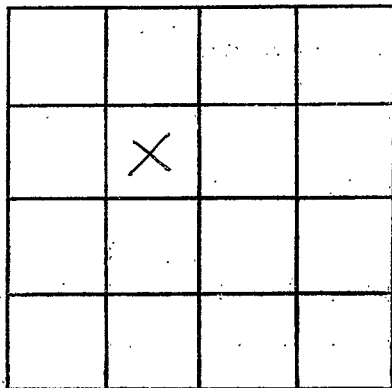

SECTION 30

Please indicate well location X.

ADDITIONAL INFORMATION

If more than one screen,
show locations of each on sketch.