

MONROE  
 J23  
 Elev # 112  
 12-13-79

MISSISSIPPI  
 BOARD OF WATER COMMISSIONERS  
 416 North State Street  
 Jackson, Mississippi 39201

CODED

WATER WELL DRILLERS LOG

12-13 1979 Live Well Co. Monroe  
 date well completed firm name county well located

LANDOWNER: MSGW 1818  
 Quincy water ass.  
 A Mary MS.  
 (mailing address)

description of formations encountered	from	to
Top Soil	0	20
red clay	20	40
red sand	40	100
Clay and sand	100	200
sand	200	320
"	320	380
sand and pea gravel	380	440

WELL LOCATION:  
 sec 30 T 13 N R 17 E  
 S W  
 6 miles East of A Mary  
 (distance) (direction) (nearest town)

WELL PURPOSE:  
 (home, irrigation, municipal, industrial)

CODED

- WELL COMPLETION DATA:
- (1) diameter (inches) 6"
  - (2) total depth (feet) 438
  - (3) static water level (feet) 200 below above top of ground.
  - (4) casing steel 411  
 (material) (depth)  
6" if telescope-see back.  
 (size)
  - (5) screen 41 404  
 (length) (depth to top)  
4 S.S.  
 (size) (material)
  - (6) pump 5 80  
 (HP) (yield gpm)  
elec.  
 (type power)
  - (7) electric log Yes  
 (yes or no)  
NP  
 (organization running log)
  - (8) how well bottom plugged Wash  
valve

23  
 1-19-79  
 3

DEPT. OF NATURAL RESOURCES  
 BUREAU OF LAND & WATER RESOURCES

JAN 22 1980


RECEIVED

DRILLERS REMARKS:

(4)

If well telescopes please sketch and show depths.

GROUND LEVEL

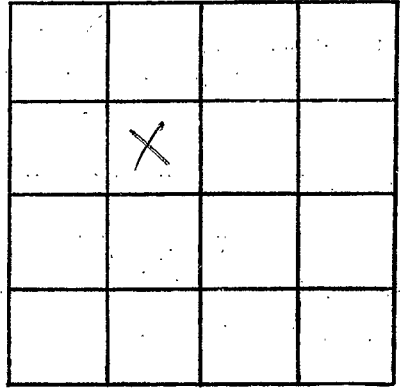

SECTION 30

Please indicate well location X.

ADDITIONAL INFORMATION

Lined area for additional information.

If more than one screen, show locations of each on sketch.