

MISSISSIPPI DEPARTMENT OF NATURAL RESOURCES

Bureau of Land and Water Resources

Southport Mall

P.O. Box 10631

Jackson, Mississippi 39209

WATER WELL DRILLERS LOG

MONROE  
J 25

CODED

1/20 1994  
date well completed

Park & Paks Water Well  
firm name

Monroe  
county well located

LANDOWNER: Mr. D. T. Munn Jr.

578 Munn Rd  
Greenwood Springs MS 38848  
(mailing address)

description of formations encountered

from

to

Clay + Red Sand	0	20
20 - 155 Blue Clay	20	155
155 - 190 White Sand	155	190
190 - 300' white sand & gravel	190	300
Gravel	300	310

WELL LOCATION:

sec. 34 T. 17 N R. 17 E  
(distance) (direction) (nearest town)  
10 miles EAST of Amory

WELL PURPOSE: Home  
(home, irrigation, municipal, industrial)

WELL COMPLETION DATA:

- (1) diameter (inches) 7"
- (2) total depth (feet) 310'
- (3) static water level (feet) 150' below top of ground.
- (4) casing PVC, 290'  
(material), (depth)  
4" if telescope see back.  
(size)
- (5) screen 20', 290'  
(length), (depth to top)  
4", PVC  
(size), (material)
- (6) pump 3/4, 700 GPM  
(HP), (yield gpm)  
ELECTRICAL  
(type power)
- (7) electric log NO  
(yes or no)  
(organization running log)
- (8) how well bottom plugged 4" Cap



JAN 27 1994


Dept. of Environmental Quality  
Office of Land & Water Resources

DRILLERS REMARKS:

Gravel circulation from 200' - 310'

If well telescopes please sketch and show depths.

GROUND LEVEL

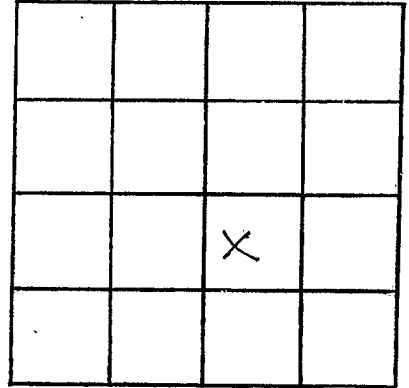

SECTION 34

Please indicate well location X.

ADDITIONAL INFORMATION

If more than one screen,  
show locations of each on sketch.