

County: monroe  
 Permit #: \_\_\_\_\_  
 Driller: Parks + Parks  
 Date drilling completed: 8/23/16

**State Well Report**  
**Part 1 - Driller's Log**  
 Mississippi Department of Environmental Quality  
 Office of Land and Water Resources  
 P.O. Box 10631  
 Jackson, MS 39289-0631  
 (601)961-5210  
 (601)354-6938 (fax)

**For Office Use Only:**

Aquifer: \_\_\_\_\_  
 Well #: J30  
 L. S. Elevation: \_\_\_\_\_  
 E-log #: \_\_\_\_\_

*State Law requires that this report be prepared by the license holder responsible for the work and filed with the Department at the above address within 30 days of completion of drilling of the well or borehole.*

Information on Well Owner <i>(Landowner if borehole is not for a water well)</i>	Well or Borehole Location
Owner Name: <u>Jonathan Clark</u>	Latitude: <u>88° 18' 16.7"</u> Longitude: <u>33° 56' 8.8"</u>
Mailing Address: <u>P.O. Box 1687</u> <u>Fulton, MS 38843</u>	Method of Lat/Long (circle one): Conventional Survey, USGS quad, Hand-held GPS, Survey-grade GPS
City: _____ State: _____ Zip Code: _____	<u>NE 1/4 SE 1/4 Sec 15 Twn 13S Rng 17W</u>
Telephone No.: <u>(662) 257 1733</u>	Distance: <u>2</u> Miles Direction: <u>North</u> of Nearest Town: <u>Green Springs, MS</u>

**Well / Borehole Data**

Date drilling started: 8/20 Date drilling completed: 8/23 Hole depth: 320 Hole diameter: 8"

Location of the source of any surface water used for drilling: \_\_\_\_\_  
 Method of dosing and volume of Chlorine used in drilling and development: SPAM

Logs run (circle all applicable): (No log run) Electric Gamma Ray Density Sonic Neutron Other: \_\_\_\_\_  
 Name of organization running log(s): \_\_\_\_\_

Purpose of borehole (check one): Water Well  Geotechnical/Geological Investigation \_\_\_\_\_ Ground Source Heat Pump \_\_\_\_\_  
 Seismic Survey \_\_\_\_\_ Other (describe) \_\_\_\_\_

*If drilling is not related to water well construction, skip the remainder of this block*

Purpose of Well (check one): Home \_\_\_\_\_ Industrial \_\_\_\_\_ Public Supply \_\_\_\_\_ Irrigation \_\_\_\_\_ Fish Culture \_\_\_\_\_ Other: Goat Farming

If a flowing well, method of flow regulation: Valve \_\_\_\_\_ Other (describe) \_\_\_\_\_

Static Water Level: 206 feet above or below (circle one) land surface Date measured: 8/25/16

Method of Measurement (circle one) steel tape electric tape air line other: \_\_\_\_\_

Well depth: 320 Well grouted to a depth of 10 feet Type of grout (circle one): Neat Cement Bentonite Mix

Casing length: 260 feet Casing diameter: 4" inches Type of casing: PVC

Screen length: 60 feet Screen diameter: 4" inches Type of screen: PVC

Screen slot size: .012 inches Setting depth: From 260 feet to 320 feet

Type of completion (circle all applicable): Gravel packed Underreamed Telescoped Open hole Natural Development  
 Other (describe): \_\_\_\_\_

Top of lap pipe or reduction in casing: \_\_\_\_\_ feet. *If telescoped or more than one screen, describe on next page*

Received  
 Form OLWR/SWR-1A

AUG 31 2016  
 By OLWR



# STATE WELL REPORT

## Part 2

**Pump Installer's Completion Report**  
 Mississippi Department of Environmental Quality  
 Office of Land and Water Resources  
 P.O. Box 10631  
 Jackson, MS 39289-0631  
 (601)961-5210  
 (601)354-6938 (fax)

County: Monroe  
 Permit #: \_\_\_\_\_  
 Driller: Parks & Parks  
 Date completed: 8/23/14  
*Copy information from block on Part 1*

**For Office Use Only:**

Aquifer: \_\_\_\_\_  
 Well #: 530  
 Elevation: \_\_\_\_\_

*This part of the report must be completed by a licensed water well contractor or a licensed pump installer. A copy of Part 1 of the report must be attached and both parts filed with the Department at the above address within 30 days of well completion.*

Well Owner Information	Well Location
Owner Name: <u>Jonathan Clark</u>	Latitude: <u>88° 18' 16.7"</u> Longitude: <u>33° 56' 8.8"</u>
Mailing Address: <u>P.O. Box 1687</u> <u>Fulton, MS 38843</u>	Method of Lat/Long (check one): Conventional Survey _____ USGS quad _____, Hand-held GPS _____, Survey-grade GPS _____
City State Zip Code	<u>NE ¼ SE ¼ Sec 15 T 13S R 17W</u>
Telephone No. <u>(662) 257-1733</u>	Distance Direction Nearest Town <u>2</u> Miles <u>North</u> of <u>Greenwood Springs</u>

Pump Type Circle one	Power Type Circle one
Air Lift Jet <input type="radio"/> <b>Submersible</b> <input checked="" type="radio"/>	Diesel Engine Gasoline Engine Natural Gas
Bucket Piston <input type="radio"/> Turbine <input type="radio"/>	<b>Electric Motor</b> <input checked="" type="radio"/> Hand <input type="radio"/> Tractor PTO <input type="radio"/>
Centrifugal Rotary <input type="radio"/> Flowing Well <input type="radio"/>	Windmill Other (specify): _____
Other (specify): _____	Horse Power Rating of Motor: <u>2</u>
Date Pump Installed: <u>8/25/16</u>	Setting Depth: <u>260</u> feet
Rated Pump Capacity: <u>20</u> Gallons Per Minute	Number of Stages: <u>18</u>

Pump Test Data	Method of Measuring Water Level Circle one
Date Well Tested: <u>8/</u>	Air Line <input type="radio"/> <b>Electric Measuring Line</b> <input checked="" type="radio"/> Steel Tape <input type="radio"/>
Static Water Level (A): <u>206</u> Feet Below Land Surface	Other (specify): _____
Pumping Water Level (B): <u>226</u> Feet Below Land Surface	For flowing well, measured shut in head: _____ feet
Drawdown [(B) - (A)]: <u>20</u> Feet Below Land Surface	Well yielded _____ GPM with a drawdown of _____ feet after _____ hours of pumping
Test Pumping Rate: <u>20</u> Gallons Per Minute	
Duration of Pump Test (minimum 4 hours): <u>4</u> hours	


I HEREBY CERTIFY that the above statements are true to the best of my knowledge.

Ryan Parks 0414 Ryan Parks **Received**  
 Print Name of Pump Installer and License No. (if applicable) Signature of Pump Installer

Form: OLWRSVR-2B16

**By OLWR**

J30

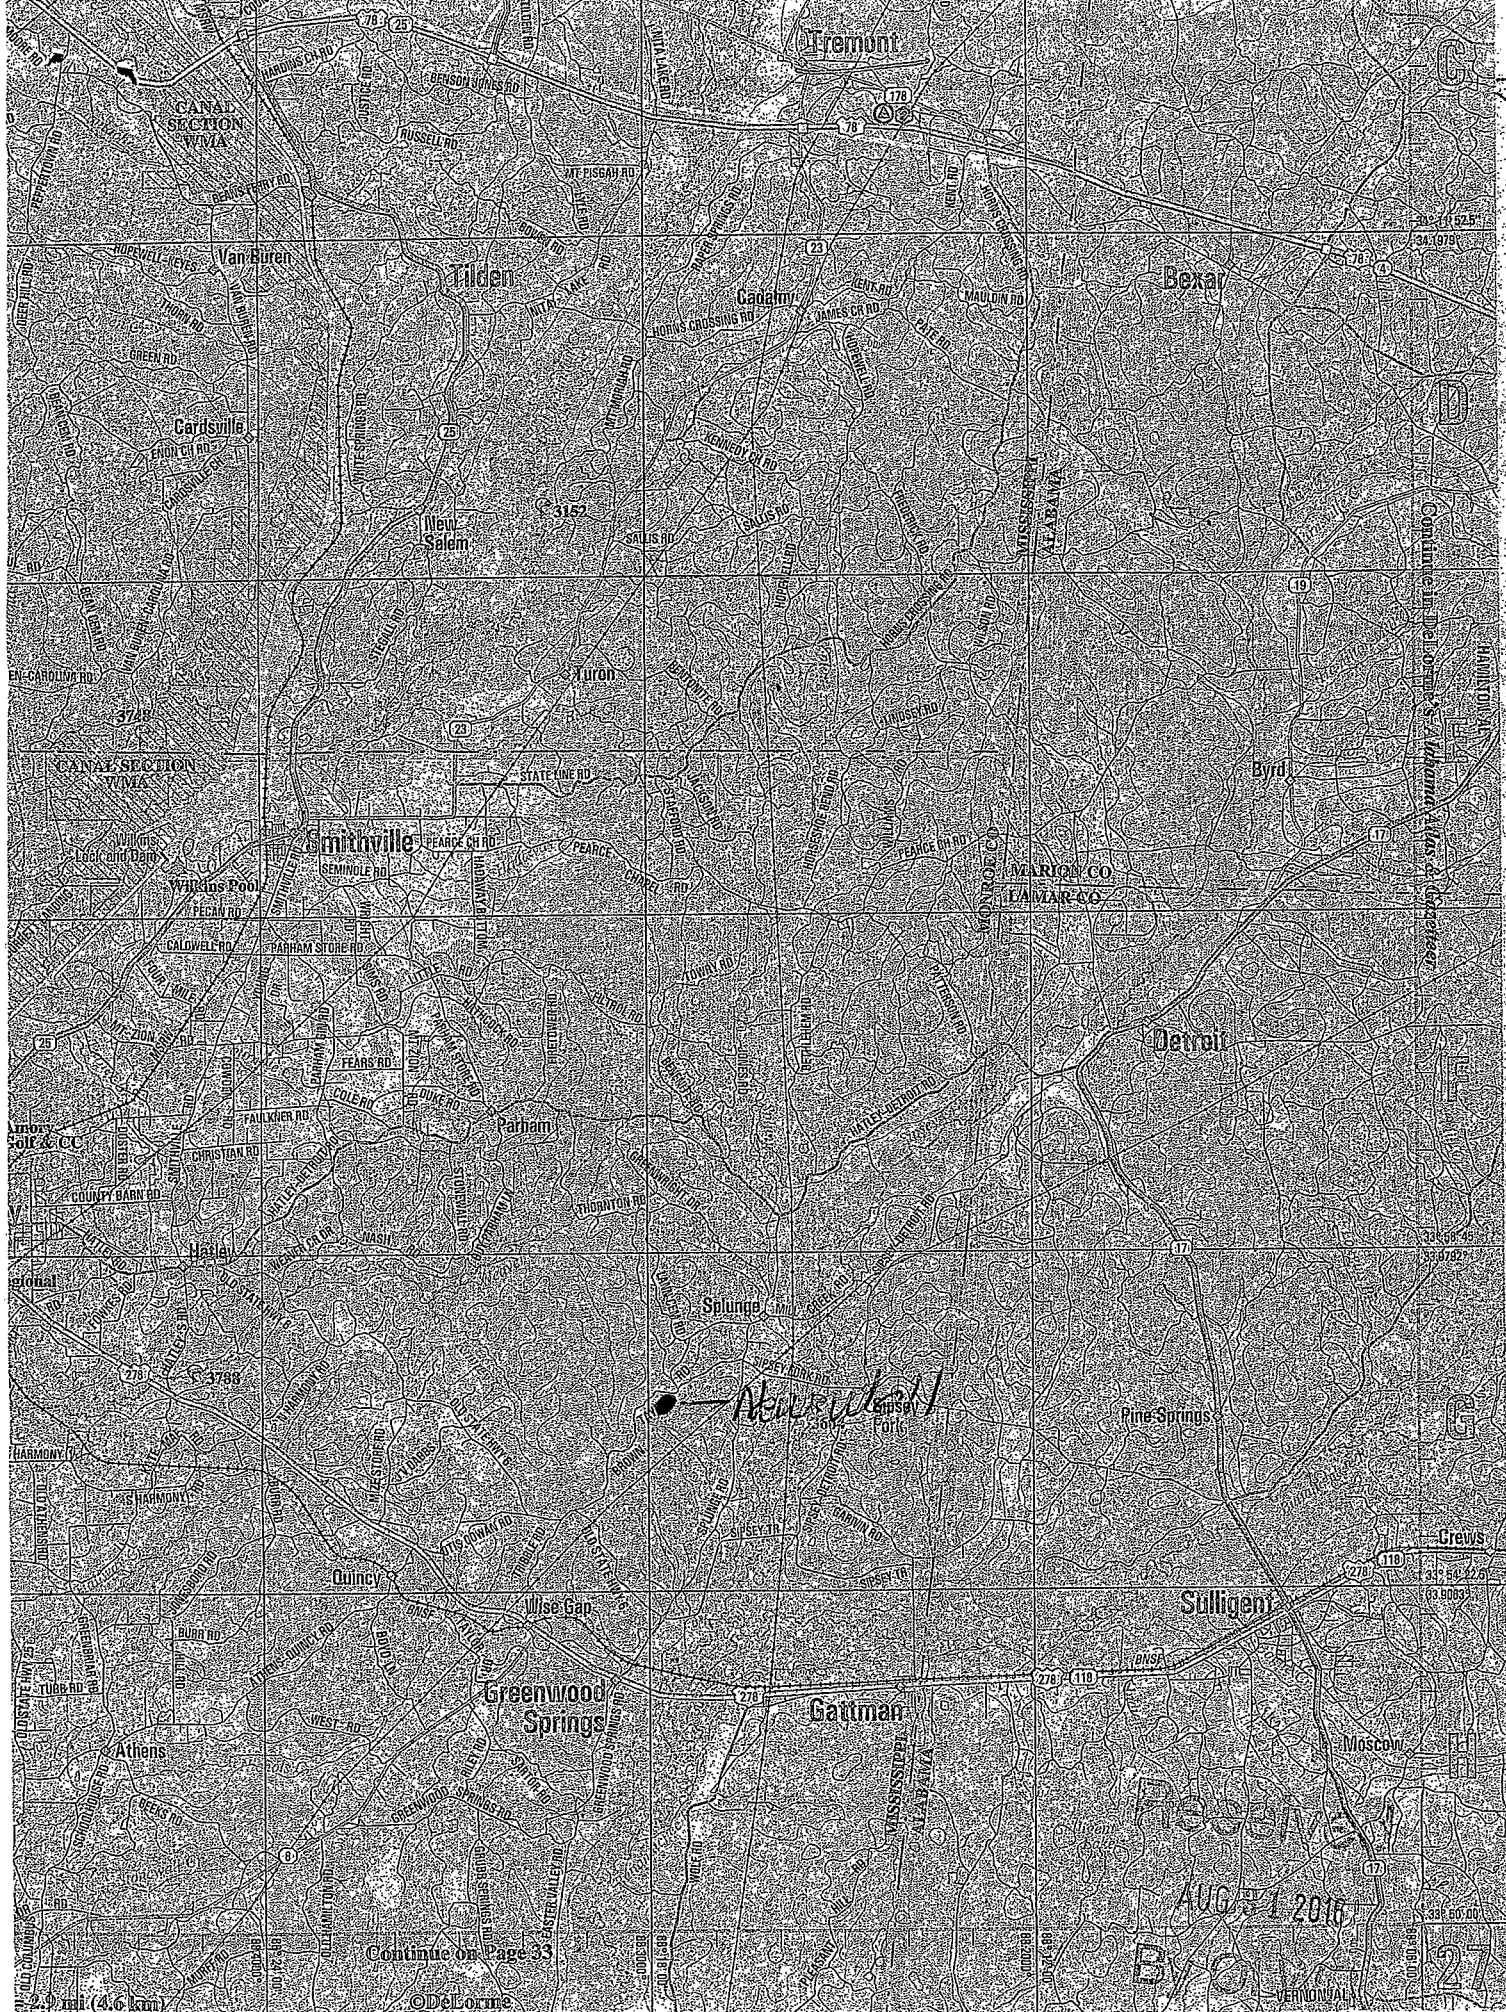

Continue on Page 33

©DeLorme

AUG 1 2016

27