

MONROE

MISSISSIPPI BOARD OF WATER COMMISSIONERS

J 2000

WATER WELL DRILLERS LOG

1-31-61

Date: 1-31, 1961, Driller: W. J. REEVES & SON County MONROE

(Name)

508-6

	Description & Color of Materials Sand, Clay, Red Clay, Shell, etc.	Thick- ness Feet	Depth Feet
(1) Owner of Land: ED FAULKNER (Name)	RED CLAY	19	0
GREENWOOD SPRINGS, MISS- (Address)	" SAND	23	19
(2) Location: 1/4, 1/4, Sec. 26 T13R17, W	BONE CLAY	73	23
15 miles E, of AMORY (distance) (direction) (Nearest Town)	GREY SAND	17	96
(3) Topography: HILLY (Hilly) (Flat) (Level)			
(4) Purpose of Well: DOMESTIC (Domestic Irrigation Municipal, Industrial, Other)			


Information upon completion of well:

- (1) Diameter 2 inches.
- (2) Total Depth 113 feet.
- (3) Water Level 68 feet below top of ground.
- (4) Cased to 103, Size 2
- (5) Screen: Size 2, Length 10
- (6) Were any formations sealed against pollution?
 yes, no.

If YES depth of formation _____

Why _____

Drillers Remarks: _____

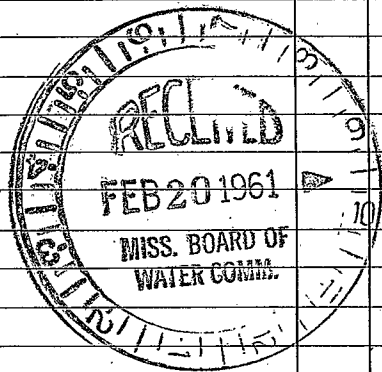

(Use Back Side)

Well No.

