

J 2002

WATER WELL DRILLERS LOG

5-14-63

Date: 5/14, 1963, Driller: HERNDON WELL & SUPPLY CO.
P. O. BOX 42 County Monroe
SHANNON MISSISSIPPI


(1) Owner of Land: Jack Johnson
 (Name)
At Amory, Miss
Spokane (Address)
 (2) Location: 1/4, 1/4, Sec 3 T 13 R 11
17
1 miles (distance) ✓ of Spokane (Nearest Town) (direction)
 (3) Topography: Hilly (Hilly) (Flat) (Level)
 (4) Purpose of Well: Domestic
 (Domestic Irrigation
 Municipal, Industrial, Other)

Description & Color of Materials Sand, Clay, Red Clay, Shell, etc.	Thick-ness Feet	Depth Feet
<u>surface sand</u>		<u>0</u>
<u>& gravel</u>		
<u>Blue sand</u>		<u>20</u>
<u>Sand</u>		<u>50</u>
<u>Bottom</u>		<u>84</u>

Information upon completion of well:

(1) Diameter 4 inches.
 (2) Total Depth 84 feet.
 (3) Water Level 40 feet below top of ground.
 (4) Cased to 79', Size 4"
 (5) Screen: Size 4", Length 5'
 (6) Were any formations sealed against pollution?
 yes, no.

If YES depth of formation 20'
 Why Surface & sand
 Drillers Remarks: Plaster casing
& succeed -

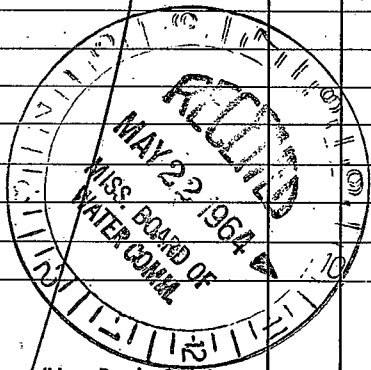

(Use Back Side)

Well No.

