

Monroe
J 2003

8-66 MISSISSIPPI BOARD OF WATER COMMISSIONERS

WATER WELL DRILLERS LOG

Date: 8-9, 1966, Driller: J. C. REEVES County MONROE
(When well drilled) (Name) (Where well is located)

(1) Owner of Land:	Description & Color of Materials Sand, Clay, Red Clay, Shell, etc.	Thick- ness Feet	Depth Feet
<u>MRS. H. O. HARRIS</u> (Name)	<u>RED CLAY</u>	<u>19</u>	<u>0</u>
<u>GREENWOOD SPRINGS</u> (Address)	<u>RED SAND</u>	<u>32</u>	<u>19</u>
(2) Location: <u>SE 1/4, NE 1/4, Sec. 1 T13R22E 17W</u>	<u>SAND & GRAVEL</u>	<u>26</u>	<u>51</u>
<u>17</u> miles <u>E</u> , of <u>ANDRY</u> (distance) (direction) (Nearest Town)			
(3) Topography: <u>HILLY</u> (Hilly) (Flat) (Level)			
(4) Purpose of Well: <u>DOM</u> (Domestic Irrigation Municipal, Industrial, Other)			

Information upon completion of well:

(1) Diameter 4 inches.
(2) Total Depth 177 feet.
(3) Water Level 40 feet below top of ground.
(4) Cased to 57, Size 4" PVC.
(5) Screen: Size 4", Length 20'.
(6) Were any formations sealed against pollution?
_____ yes, _____ no.

If YES depth of formation _____


Why _____

Drillers Remarks: _____

Yield in gpm: 20

Size pump: 1/2 H.P. SUB

Type power: ELECTRIC

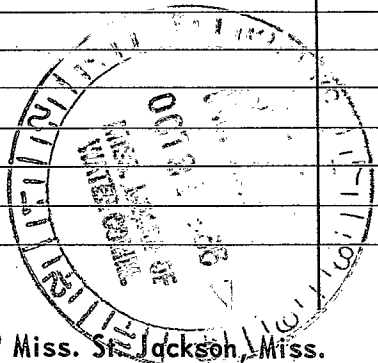

[The page contains extremely faint and illegible text, likely bleed-through from the reverse side of the document. The text is too light to transcribe accurately.]