

Need date

MISSISSIPPI BOARD OF WATER COMMISSIONERS
416 North State Street
Jackson, Mississippi 39201

Monroe
J 2007
Dec 2

WATER WELL DRILLERS LOG

Dec 2 - 76 1976 date well completed
Mid South Drilling firm name
Monroe county well located

LANDOWNER: <u>W. D. Baker</u>	description of formations encountered	from	to
<u>Rt. 1 Box 201</u> <u>Shenwood Springs 38848</u> (mailing address)			
WELL LOCATION: sec. <u>8</u> T. <u>13</u> N. R. <u>16</u> W. S. <u>4</u>	<u>Sand & Clay</u>	<u>23</u>	<u>94</u>
<u>7</u> miles <u>West</u> of <u>Sultiger</u> (distance) (direction) (nearest town)	<u>Sand</u>	<u>94</u>	<u>120</u>
WELL PURPOSE: <u>Home</u> (home, irrigation, municipal, industrial)			
WELL COMPLETION DATA: (1) diameter (inches) <u>4</u>			
(2) total depth (feet) <u>120</u>			
(3) static water level (feet) <u>47</u> below top of ground.			
(4) casing <u>PVC</u> , <u>120</u> (material) (depth)			
(size) if telescope see back.			
(5) screen <u>10'</u> , <u>110'</u> (length) (depth to top)			
<u>4"</u> , <u>PVC</u> (size) (material)			
(6) pump <u>1/2</u> , <u>5</u> (HP) (yield gpm)			
<u>AC</u> (type power)			
(7) electric log <u>yes or no</u>			
(organization running log)			
(8) how well bottom plugged <u>wash valve</u>			
DRILLERS REMARKS:			


RECEIVED

JAN 3 1977

MISS. BD. OF WATER COMM.

If well telescopes please sketch and show depths.

GROUND LEVEL

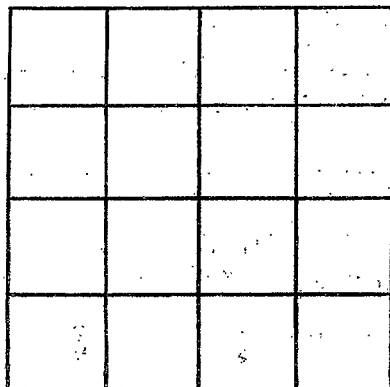

SECTION _____

Please indicate well location X.

ADDITIONAL INFORMATION

If more than one screen, show locations of each on sketch.