

Monroe
J 2011

MISSISSIPPI
BOARD OF WATER COMMISSIONERS
416 North State Street
Jackson, Mississippi 39201

WATER WELL DRILLERS LOG

May 19 88 LEEPER Drilling Monroe
date well completed firm name county well located

LANDOWNER: Bill Haney
RED Hatley, Ms.

(mailing address)

WELL LOCATION:

sec. 8 T 13 N R 11 W
(S) NE of AMORY
(distance) (direction) (nearest town)

WELL PURPOSE: HOME
(home, irrigation, municipal, industrial)

WELL COMPLETION DATA:

- (1) diameter (inches) 4"
(2) total depth (feet) 127
(3) static water level (feet) 110 ^{below}/_{above} top of ground.
(4) casing PVC 117
(material) (depth)
4" if telescope see back.
(size)
(5) screen 10' 117
(length) (depth to top)
4" PVC
(size) (material)
(6) pump 1 10
(HP) (yield gpm)
Elec
(type power)
(7) electric log NO
(yes or no)

(organization running log)

- (8) how well, bottom plugged BACK
wash valve

DRILLERS REMARKS:

description of formations encountered

from

to


TOP clay	0	10
Red Sand	10	100
Blue Clay	100	115
White Sand	115	127

DISSEMINATED
AUG 04 1988

Department of Natural Resources
Bureau of Land & Water Resources

If well telescopes please sketch and show depths.

GROUND LEVEL

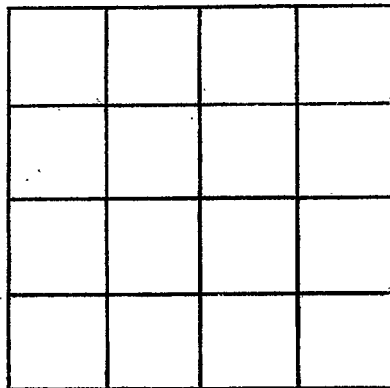

SECTION _____

Please indicate well location X.

ADDITIONAL INFORMATION

If more than one screen, show locations of each on sketch.