

MONROE
J 2012

MISSISSIPPI
BOARD OF WATER COMMISSIONERS
416 North State Street
Jackson, Mississippi 39201

WATER WELL DRILLERS LOG

MAY 1988 LEEPER Drilling MONROE
date well completed firm name county well located

LANDOWNER: Ralph Reeves
RED Hartley, MS

(mailing address)

WELL LOCATION:

sec. 7 T. 13 N. R. 9 E. 1 W
6 miles NE of Amoy
(distance) (direction) (nearest town)

WELL PURPOSE: Home
(home, irrigation, municipal, industrial)

WELL COMPLETION DATA:

- (1) diameter (inches) 4"
- (2) total depth (feet) 117
- (3) static water level (feet) 80 ^{below}/_{above} top of ground.
- (4) casing PVC 107.
(material) (depth)
4" (size) if telescope see back.
- (5) screen 10' 107
(length) (depth to top)
4" PVC
(size) (material)
- (6) pump 1 15
(HP) (yield gpm)
51cc
(type power)
- (7) electric log (yes or no)

(organization running log)

(8) how well bottom plugged
Back wash valve

DRILLERS REMARKS:

description of formations encountered

from

to

Top Clay	0	10
Red Sand	10	90
Blue Clay	90	100
White Sand	100	117


RECEIVED

AUG 04 1988

Department of Natural Resources
Bureau of Land & Water Resources

If well telescopes please sketch and show depths.

GROUND LEVEL

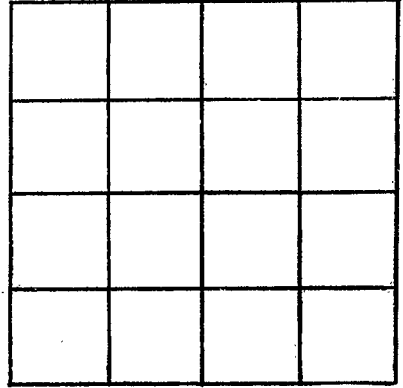

SECTION _____

Please indicate well location X.

ADDITIONAL INFORMATION

If more than one screen,
show locations of each on sketch.