

MISSISSIPPI DEPARTMENT OF ENVIRONMENTAL QUALITY
Bureau of Land and Water Resources

P. O. Box 10631
Jackson, MS 39289-0631
WATER WELL DRILLERS LOG

| | |
|---------------------------------------|--------------------|
| COUNTY WELL LOCATED <i>Monroe</i> | |
| WELL NUMBER <i>20</i> | CODED <i>13</i> |
| DATE WELL COMPLETED <i>5/29-92</i> | |

| |
|--|
| PERMIT NUMBER |
| NAME OF DRILLING FIRM <i>Kossi Drilling</i> |

| | | | |
|--|------------|--------------|----------|
| NAME & MAILING ADDRESS OF LANDOWNER <i>Williams Crump</i> | | | |
| <i>Rt 2 Box 303</i> | | | |
| <i>Aberdeen Ms. 39730</i> | | | |
| WELL LOCATION: SEC | TOWNSHIP | RANGE | |
| <i>36</i> | <i>135</i> | <i>S 17</i> | <i>E</i> |
| DISTANCE | DIRECTION | NEAREST TOWN | |
| _____ Miles | _____ of | _____ | |
| OTHER LANDMARK | | | |
| WELL PURPOSE: <input checked="" type="checkbox"/> Home, Irrigation, Municipal, Industrial, Fish Pond, etc. | | | |

| | | |
|--|---------------|---------------|
| PUMP DATA | | |
| PUMP TYPE (Circle One): Submersible, Turbine, Jet, Flowing Well, Other (Describe) _____ | | |
| POWER TYPE (Circle One): Electric, Tractor, Diesel, Gasoline, Butane, Other (Describe) _____ H/P _____ | | |
| Pump Capacity (GPM) | No. of Stages | Setting Depth |
| _____ | _____ | _____ FT. |
| PUMP TEST | | |
| Well yielded _____ GPM with | | |
| a drawdown of _____ ft. | | |
| after _____ hours of pumping | | |

| | | |
|--|--|---|
| WELL DATA | | |
| Well Depth <i>100'</i> | Casing Diameter (In.) <i>4"</i> | Casing Length (Ft.) <i>90'</i> |
| Type of Casing <i>PVC</i> | Hole Depth <i>100'</i> | Depth to Static Water Level <i>64'</i> |
| TYPE OF COMPLETION: (Circle One or More): <input checked="" type="checkbox"/> Gravel Packed, <input type="checkbox"/> Underreamed, <input type="checkbox"/> Telescoped, <input type="checkbox"/> Natural Development, <input type="checkbox"/> Open Hole, <input type="checkbox"/> Other (Describe) _____ | | |
| Top of Lap Pipe or Reduction in Casing | | |
| FEET | IF TELESCOPED OR MORE THAN ONE SCREEN: USE BACK PAGE | |

| | |
|--|--|
| LOG DATA | |
| TYPE OF LOG RUN (Circle One): No Log Run, Electric, Gamma Ray, Density, Sonic, Neutron, Other (Describe) <i>None</i> | |
| Name of Organization Running Log | |

| | | |
|--------------------------------|--------------------------------------|-----------------------------------|
| SCREEN DATA | | |
| Diameter - Inches <i>4"</i> | Length - Feet <i>10</i> | Slot Size - Inches <i>1013</i> |
| Screen Type <i>P10</i> | Depth to Bottom - Feet <i>10'</i> | |

| | | | |
|--|---------------|----------------|--------------|
| GEOLOGIC DATA (Office Use Only) | | | |
| Surface Elev. | Geologic Unit | Unit Thickness | Depth to Top |
| Subs. SWL | Date | Analysis | Aquifer Test |


| |
|-------------------|
| Driller's Remarks |
| |
| |

| DESCRIPTION OF FORMATIONS ENCOUNTERED | FROM | TO | FORMATIONS (Continued) | FROM | TO |
|---------------------------------------|-----------|------------|---|------|----|
| <i>clay</i> | <i>0</i> | <i>49</i> | RECEIVED JUN 08 1993 Dept. of Environmental Quality Office of Land & Water Resources | | |
| <i>sand</i> | <i>49</i> | <i>75</i> | | | |
| <i>sand + gravel</i> | <i>75</i> | <i>100</i> | | | |
| | | | | | |
| | | | | | |
IF MORE SPACE IS NEEDED, USE BACK

If well telescopes please sketch and show depths.

GROUND LEVEL

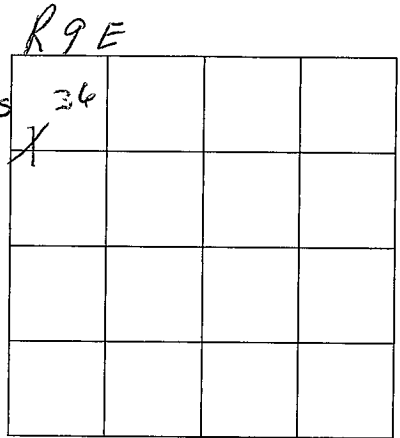

SECTION 36

Please indicate well location X.

ADDITIONAL INFORMATION

If more than one screen,
show location of each on sketch.