

**MISSISSIPPI DEPARTMENT OF ENVIRONMENTAL QUALITY**

Office of Land and Water Resources

P. O. Box 10631  
Jackson, MS 39289-0631

**WATER WELL DRILLERS LOG**

COUNTY WELL LOCATED	
Monroe	
WELL NUMBER	CODED
2857	
DATE WELL COMPLETED	
9-22-97	

PERMIT NUMBER
0-379
NAME OF DRILLING FIRM
Mid-South Drilling
Carrollton, AL 35447

NAME & MAILING ADDRESS OF LANDOWNER			
Laverne Munn			
60309 Sipsey Detroit Rd.			
Greenwood Springs, MS 38848			
WELL LOCATION:	SEC	TOWNSHIP	RANGE
	8	13	10
		N	E
		S	W
DISTANCE	DIRECTION	NEAREST TOWN	
5	Miles N	of Gattman	
OTHER LANDMARK			
WELL PURPOSE: Home, Irrigation, Municipal, Industrial, Fish Pond, etc.			
home			

PUMP DATA		
PUMP TYPE (Circle One):		
Submersible,	Turbine,	Jet
Flowing Well, Other (Describe) _____		
POWER TYPE (Circle One):		
Electric,	Tractor,	Diesel,
Gasoline, Butane, Other (Describe) _____		
Pump Capacity (GPM)	No. of Stages	Setting Depth
		FT.
PUMP TEST		
Well yielded _____ GPM with		
a drawdown of _____ ft.		
after _____ hours of pumping		

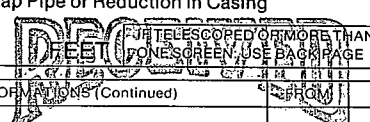
WELL DATA		
Well Depth	Casing Diameter (In.)	Casing Length (Ft.)
75	4	70
Type of Casing	Hole Depth	Depth to Static Water Level
PVC	75	56'
TYPE OF COMPLETION: (Circle One or More):		
Gravel Packed, Underreamed, Telescoped,		
Natural Development, Open Hole, Other		
(Describe) _____		
WELL GROUTED TO A DEPTH OF _____ FEET		
Type Grout (circle one): Cement, Bentonite, or Mix		

LOG DATA	
TYPE OF LOG RUN (Circle One):	
Electric,	Gamma Ray, Density, Sonic, Neutron,
Other (Describe) _____	
Name of Organization Running Log	
No Log Run	

SCREEN DATA		
Diameter - Inches	Length - Feet	Slot Size - Inches
4	5	.032
Screen Type	Depth to Bottom - Feet	
PVC		

GEOLOGIC DATA (Office Use Only)			
Surface Elev.	Geologic Unit	Unit Thickness	Depth to Top
Subs. SWL	Date	Analysis	Aquifer Test

DESCRIPTION OF FORMATIONS ENCOUNTERED	FROM	TO
clay	000	009
sand	009	033
clay	033	043
sand	043	054
clay	053	057
sand	057	075

Driller's Remarks	
Top of Lap Pipe or Reduction in Casing	
	
DEPT. OF ENVIRONMENTAL QUALITY OFFICE OF LAND & WATER RESOURCES	
IF MORE SPACE IS NEEDED, USE BACK	

If well telescopes please  
sketch and show depths.

GROUND LEVEL


SECTION \_\_\_\_\_

Please indicate well location X.

ADDITIONAL INFORMATION

If more than one screen,  
show location of each on sketch.