

K
6-18-64

WATER WELL DRILLERS LOG

HEPNDON WELL & SUPPLY CO. *Monroe*

Date: *6/18*, 19*64*, Driller:

P. O. BOX 42

County *Franklin*

SHANNON, MISSISSIPPI

(1) Owner of Land: *Allen Walker*
(Name)

Abbeville, Miss
(Address)

(2) Location: $\frac{1}{4}$, $\frac{1}{4}$, Sec *19*, T *143*, R *6*

Gibson
miles, of *Abbeville*
(distance) (direction) (Nearest Town)

(3) Topography: *Flat*
(Hilly) (Flat) (Level)

(4) Purpose of Well: *Domestic*
(Domestic Irrigation
Municipal, Industrial, Other)

Description & Color of Materials
Sand, Clay, Red Clay, Shell, etc.

Thick-
ness
Feet

Depth
Feet

surface sand
5 clay
Blue sand
5
sand
6
Bottom

0
20
300
420

Information upon completion of well:

(1) Diameter *5* inches.

(2) Total Depth *420* feet.

(3) Water Level *100* feet below top of ground.

(4) Cased to *23'*, Size *5"*

(5) Screen: Size *✓*, Length *✓*


(6) Were any formations sealed against pollution?

✓ yes, *no.*

If YES depth of formation *20'*

Why *surface sand*

Drillers Remarks:

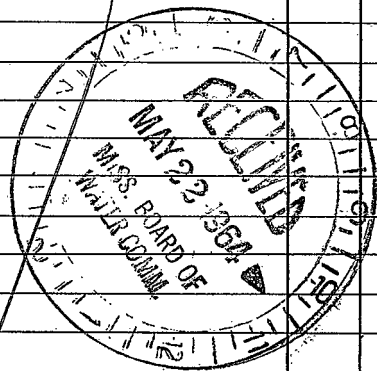

Well No.

(Use Back Side)

