

Monroe
K17
8-30-68

MISSISSIPPI
BOARD OF WATER COMMISSIONERS
416 North State Street
Jackson, Mississippi 39201

CODED

CODED

WATER WELL DRILLERS LOG

Herndon-Homan Well & Supply, Inc. Monroe

8-30 19-68
date well completed

firm name
SHANNON, MISSISSIPPI 39269


county well located.

LANDOWNER:	description of formations encountered	from	to
(mailing address)			
Calvin Coptea (Contractor)	Surface clay	0	18
Box 3 Aberdeen, Miss	Blk clay	18	280
	Sand	280	400
	Soft	400	
<p>WELL LOCATION:</p> <p>sec. <u>31</u> T. <u>14</u> N. R. <u>6</u> E. S. <u>5</u> W.</p> <p><u>1 1/2</u> miles <u>S</u> of <u>Gibson</u></p> <p>(distance) (direction) (nearest town)</p>			
<p>WELL PURPOSE: <u>Home</u></p> <p>(home, irrigation, municipal, industrial)</p>			
<p>WELL COMPLETION DATA:</p> <p>(1) diameter (inches) <u>5"</u></p> <p>(2) total depth (feet) <u>400'</u></p> <p>(3) static water level (feet) <u>100'</u> below above top of ground.</p> <p>(4) casing <u>Steel</u>, <u>2 1/4"</u> (material) (depth)</p> <p><u> </u> if telescope see back. (size)</p> <p>(5) screen <u>NO</u> (length) (depth to top)</p> <p><u> </u> (size) (material)</p> <p>(6) pump <u>1/2</u> <u>5</u> (HP) (yield gpm)</p> <p><u>electric</u> (type power)</p> <p>(7) electric log <u>NO</u> (yes or no)</p> <p><u> </u> (organization running log)</p> <p>(8) how well bottom plugged <u>open</u></p>			
<p>DRILLERS REMARKS:</p>			

MISSISSIPPI
BOARD OF WATER COMMISSIONERS
WATER CONTROL

If well telescopes please
sketch and show depths.

GROUND LEVEL

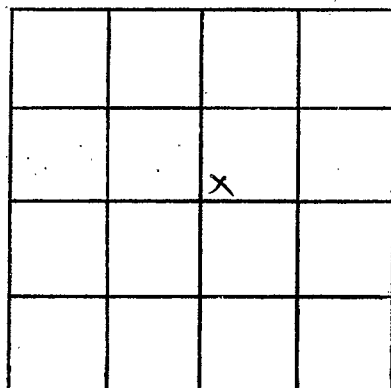

SECTION 31

Please indicate well location X.

ADDITIONAL INFORMATION

If more than one screen,
show locations of each on sketch.