

CODED

MISSISSIPPI
BOARD OF WATER COMMISSIONERS
416 North State Street
Jackson, Mississippi 39201

CODED

WATER WELL DRILLERS LOG

Monroe
R18
8-22-68

8-22-1968 Harndon-Homan Well & Supply, Inc. Monroe
date well completed firm name Box 42 county well located

JEFFERSON, MISSISSIPPI 39202

LANDOWNER:

Melvin Shawcross
P.O. 3 Aberdeen, Miss
(mailing address)

description of formations encountered

from to

Surface clay 0 18
Blue clay 18 280
Sand 280 400
Bott 400

WELL LOCATION:

sec. 4 T 14 N R 6 E
S W
6 miles NW of Aberdeen
(distance) (direction) (nearest town)

WELL PURPOSE: Home
(home, irrigation, municipal, industrial)

WELL COMPLETION DATA:

- (1) diameter (inches) 5
- (2) total depth (feet) 400
- (3) static water level (feet) 125' below top of ground.
- (4) casing steel, 21' 3" (material) (depth)
5 (size) if telescope see back.
- (5) screen ND (length) (depth to top)
(size) (material)
- (6) pump 1/2 (HP) 5 (yield gpm)
electric (type power)
- (7) electric log NO (yes or no)

(organization running log)

(8) how well bottom plugged open


DRILLERS REMARKS:

OCT 16 1968

MISS. DDx 61
WATER COMMISSION

If well telescopes please sketch and show depths.

GROUND LEVEL

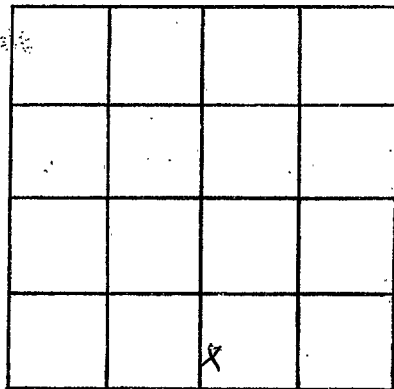

SECTION f

Please indicate well location X.

ADDITIONAL INFORMATION

If more than one screen, show locations of each on sketch.