

Monroe  
K 19  
3-30-69

MISSISSIPPI  
 BOARD OF WATER COMMISSIONERS  
 416 North State Street  
 Jackson, Mississippi 39201

**CODED**

WATER WELL DRILLERS LOG

3-30 1969 Herndon-Homan Well & Supply, Monroe  
 date well completed firm name Box 42 county well located  
 SHANNON, MISSISSIPPI 38868

LANDOWNER:

C.W. Whitley  
Abe Doo, Miss.  
 (mailing address)

description of formations encountered

from to

Spring clay 0-18  
Blue clay 18-130  
Sand 130-200  
Bottom 200

WELL LOCATION:

sec. 3 T. 4 N. R. 6 E.  
9 miles E of Egg  
 (distance) (direction) (nearest town)

WELL PURPOSE:

Home  
 (home, irrigation, municipal, industrial)

WELL COMPLETION DATA:

- (1) diameter (inches) 5
- (2) total depth (feet) 300'
- (3) static water level (feet) 85 below top of ground.
- (4) casing steel, 2 1/4"  
 (material) (depth)
- 5  
 (size) if telescope see back.
- (5) screen NO  
 (length) (depth to top)
- (size) (material)
- (6) pump 1/3 5  
 (HP) (yield gpm)
- electric  
 (type power)
- (7) electric log NO  
 (yes or no)

(organization running log)

(8) how well bottom plugged open

DRILLERS REMARKS:


**CODED**

MAY 20 1969

MISS. BD. OF  
 WATER COMM.

If well telescopes please sketch and show depths.

GROUND LEVEL

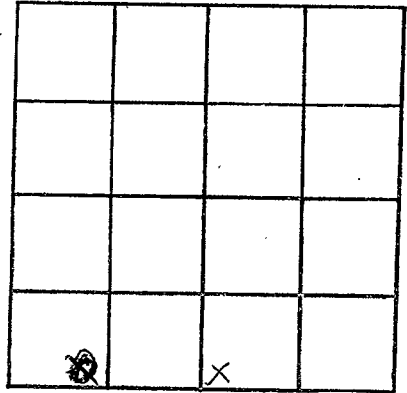

SECTION 5

Please indicate well location X.

ADDITIONAL INFORMATION

Lined area for additional information.

If more than one screen, show locations of each on sketch.