

Monroe
K 20,
4-69

MISSISSIPPI
BOARD OF WATER COMMISSIONERS
416 North State Street
Jackson, Mississippi 39201

WATER WELL DRILLERS LOG

Meradon-Homan Well & Supply, Inc.

Monroe

19 68
date well completed

P. O. Box 48
SHANNON, MISSISSIPPI 38868
county well located

LANDOWNER:	description of formations encountered	from	to
Bernice Newmyer R3 Aberdeen, Miss (mailing address)	surface sand & clay blue clay sand bottom	0-28	28-350
WELL LOCATION: sec. 4 T 14 N R 6 E 2 1/2 miles E of Egypt (distance) (direction) (nearest town)			
WELL PURPOSE: Home (home, irrigation, municipal, industrial)			
WELL COMPLETION DATA:			
(1) diameter (inches) 5			
(2) total depth (feet) 400			
(3) static water level (feet) 50 below top of ground.			
(4) casing Steel, 30, (material) (depth)			
5 (size) if telescope see back.			
(5) screen 20 (length) (depth to top)			
(size) (material)			
(6) pump 1/2 5 (HP) (yield gpm)			
elect (type power)			
(7) electric log 20 (yes or no)			
(organization running log)			
(8) how well bottom plugged open			


MAY 26 1969

MISS. BD. OF
WATER COMM.

DRILLERS REMARKS:

If well telescopes please sketch and show depths.

GROUND LEVEL

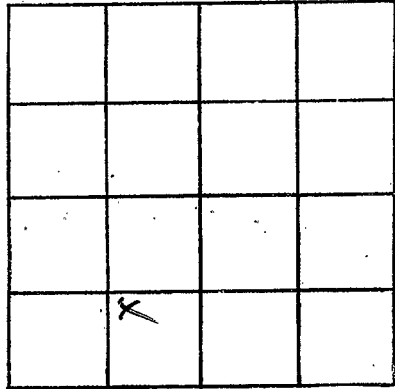

SECTION

f

Please indicate well location X.

ADDITIONAL INFORMATION

If more than one screen, show locations of each on sketch.