

Monroe
R 21
4-26-69

MISSISSIPPI
 BOARD OF WATER COMMISSIONERS
 416 North State Street
 Jackson, Mississippi 39201

WATER WELL DRILLERS LOG

4-26 1969
 date well completed

Herndon-Homan Well & Supply, Inc. Monroe
 firm name county well located
 T. O. Box 12
 SHANNON, MISSISSIPPI 38664

LANDOWNER: contractor
Catrina Clepton
423, Aberdeen, Miss
 (mailing address)

description of formations encountered	from	to
<u>Surface sand & clay</u>		<u>0-25</u>
<u>Other clay</u>	<u>25</u>	<u>150</u>
<u>Spand</u>	<u>150-300</u>	
<u>Bottom</u>	<u>300</u>	

WELL LOCATION:
 sec. 4 T. 4 N. R. 6 E.
8 miles SW of Aberdeen
 (distance) (direction) (nearest town)

WELL PURPOSE: Home
 (home, irrigation, municipal, industrial)

WELL COMPLETION DATA:

- diameter (inches) 5
- total depth (feet) 300
- static water level (feet) 83 below top of ground.
- casing Steel, 33 (material) (depth)
5 if telescope see back. (size)
- screen NO (length) (depth to top)
 (size) (material)
- pump 1/3 (HP) 5 (yield gpm)
electric (type power)
- electric log NO (yes or no)

(organization running log)

(8) how well bottom plugged open

DRILLERS REMARKS:


Revised Sub

MAY 20 1969

MISS. BD. OF
 WATER COMM.

If well telescopes please sketch and show depths.

GROUND LEVEL

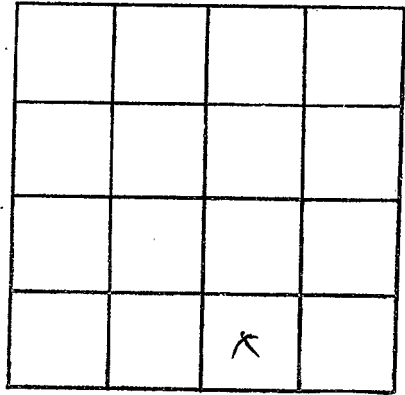

SECTION 4

Please indicate well location X.

ADDITIONAL INFORMATION

Lined area for additional information.

If more than one screen, show locations of each on sketch.